

# SCHOOLCRAFT COUNTY PEER GROUP APPROVED

SURVEY &  
REMONUMENTATION

DATE 10/21/98 <sup>JOB</sup> LAND CORNER RECORDATION CERTIFICATE  
Filing Requirement of Act 74, Mich. P.A. 1970

JAN 21 1999

For corners in

Schoolcraft \_\_\_\_\_ Located In: \_\_\_\_\_ Corner Code # \_\_\_\_\_  
(County)

1. Public Land Survey T41NR16W D-7  
T \_\_\_\_\_ R \_\_\_\_\_  
T \_\_\_\_\_ R \_\_\_\_\_  
T \_\_\_\_\_ R \_\_\_\_\_

2. Property Controlling S \_\_\_\_\_ T \_\_\_\_\_ R \_\_\_\_\_  
in Section S \_\_\_\_\_ T \_\_\_\_\_ R \_\_\_\_\_

3. Miscellaneous S \_\_\_\_\_ T \_\_\_\_\_ R \_\_\_\_\_  
Property in Sec. S \_\_\_\_\_ T \_\_\_\_\_ R \_\_\_\_\_

SIGRID HEDBERG 1P  
SCHOOLCRAFT CO. REGISTER  
Page 1 of 1 LC 4/230  
JLV Rec. Date 12/03/98 Time 14:42  
REVENUE FEES: 9.00

SECTION

Register of Deeds Stamp & File Number

4. Lot No. \_\_\_\_\_, Recorded Plat \_\_\_\_\_  
5. Private Claims \_\_\_\_\_

	A	B	C	D	E	F	G	H	I	J	K	L	M
1													
2	6			5			4		3			2	1
3													
4	7			8			9		10			11	12
5													
6	18			17			16		15			14	13
7				X									
8	19			20			21		22			23	24
9													
10	30			29			28		27			26	25
11													
12	31			32			33		34			35	36
13													

Thomas P. O'Brien in a field survey on Oct. 29, 1998 do hereby state that under requirements of P.A. 74, Michigan P.A. of 1970, the corner points mentioned in lines 1 and 2 above were in conformance with regulations and rules therefore as required in the current manual of survey instructions of the United States Department of the Interior, Bureau of Land Management or by a decree of a Court of Law and/or that the corner points mentioned in lines 3, 4 and 5 above were in conformance with the rules of the Michigan Board of Land Surveyors or by a Decree of a Court of Law, established, re-established, monumented, recovered, found as expressed below:

NOTE: Not more than 2 corners, all in the same town and range, may be recorded on this certificate.

A. Description of original monument and accessories and/or subsequent restoration:

D7 S 1/4 Corner Section 17, T41N - R16W  
Sept. 13, 1845 - John Burt D.S. set qr. section post referenced by:  
Hemlock 10 N 46 W 8 Hemlock 7 S 5 E 6  
April 4, 1983 - L.C.R.C. by David B. Babbitt (L.1 Pg. 320 R.L.S.21558)  
indicates the corner as a found 3" pipe with brass cap as set by Gregory A. Shadko L.S. in 1940.  
April 11, 1995 - L.C.R.C. by Gerald W. Carlson (L.4 Pg.167 P.S.24589)  
indicates corner as a 3" pipe with 3 3/4" diameter State of Michigan brass cap.  
"Fd. BT's with scribed blazes and distances to faces fit well with recorded ones by Babbitt (8-8-83)"


B. Description of corner evidence found and/or method applied in restoring or reestablishing corner:

D7 Oct. 29, 1998 - Thomas P. O'Brien P.S. recovered a 3 1/2" pipe with 3 3/4" State of Michigan brass cap as set by Gregory A. Shadko L.S. 1940.  
Witnesses found check well with Carlson Land Corner Record (L.4 Pg.167 P.S.24589).

C. Description of monument for corner and accessories established to perpetuate locating the position of the corner:

D7 3 1/2" pipe with 3 3/4" State of Michigan brass cap stamped to identify.  
Repainted blazes on NBT's and made measurements to the following references:

(Fd.) 10" W.Pine - N8°E - 35.14'  
(Fd.) 12" W.Pine - S52°E - 37.48'  
(Fd.) 20" W.Pine - N75°W - 50.33'  
(Fd.) 15" W.Pine - N53°W - 19.94'  
Carsonite post - South - 1.0'

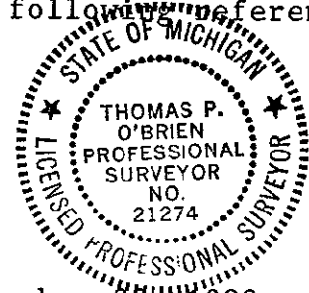

Signed by Thomas P. O'Brien

Date November 23, 1998

Surveyor's Michigan License No. 21274