

JAN 21 1999

SCHOOLCRAFT COUNTY PEER GROUP APPROVED

DATE 10/21/98 OJB

SECTION

LAND CORNER RECORDATION CERTIFICATE Filing Requirement of Act 74, Mich. P.A. 1970

For corners in

Schoolcraft (County)	Located In:	Corner Code #
1. Public Land Survey	T 41N R 16W	E-11
	T R	
	T R	
	T R	
2. Property Controlling in Section	S T R	
	S T R	
3. Miscellaneous Property in Sec.	S T R	
	S T R	

SIGRID HEDBERG
 SCHOOLCRAFT CO. REGISTER 1P
 Page 1 of 1 LC 4/ 235
 JLO Rec. Date 12/03/98 Time 14:43
 REVENUE FEES: 9.00

Register of Deeds Stamp & File Number

4. Lot No. _____, Recorded Plat _____
 5. Private Claims _____

I, Thomas P. O'Brien in a field survey on Oct. 28, 1998 do hereby state that under requirements of P.A. 74, Michigan P.A. of 1970, the corner points mentioned in lines 1 and 2 above were in conformance with regulations and rules therefore as required in the current manual of survey instructions of the United States Department of the Interior, Bureau of Land Management or by a decree of a Court of Law and/or that the corner points mentioned in lines 3, 4 and 5 above were in conformance with the rules of the Michigan Board of Land Surveyors or by a Decree of a Court of Law, established, re-established, monumented, recovered, found as expressed below:

NOTE: Not more than 2 corners, all in the same town and range, may be recorded on this certificate.

	A	B	C	D	E	F	G	H	I	J	K	L	M
1													
2	6		5		4		3		2		1		
3													
4	7		8		9		10		11		12		
5													
6	18		17		16		15		14		13		
7													
8	19		20		21		22		23		24		
9													
10	30		29		28		27		26		25		
11					X								
12	31		32		33		34		35		36		
13													

A. Description of original monument and accessories and/or subsequent restoration:

E11 NW Corner Section 33, T41N - R16W
 Sept. 13, 1845 - John Burt D.S. set post corner of sections 28, 29, 32 & 33
 Referenced by : Cedar 8 N 76 W 18 Y. Pine 8 S 40 E 37
 May 25, 1950 - Carl Christensen, County Surveyor set 2" Iron Pipe with brass cap from Cedar 8" N76°W 18 lks.
 Aug. 28, 1968 - LCRC by Frank J. Bray (L.3 Pg. 186 RLS).
 Aug. 18, 1986 - LCRC by Gary E. Koepke (L.2 Pg. 31 L.S. 26458).


B. Description of corner evidence found and/or method applied in restoring or reestablishing corner:

E11 Oct. 28, 1998 - Thomas P. O'Brien P.S. recovered a 2" Iron Pipe with 2 1/4" brass cap stamped C.C. All former witness trees are down and dead.

C. Description of monument for corner and accessories established to perpetuate locating the position of the corner:

E11 2" iron pipe with 2 1/4" brass cap stamped to identify. Established the following references which are blazed, scribed, and tagged:

- NBT 6" Cedar - N22°E - 15.19'
- NBT 6" Cedar - N82°E - 49.10'
- NBT 5" Cedar - S27°W - 25.00'
- NBT 4" Cedar - N74°W - 10.75'
- Carsonite post - North - 1.0'

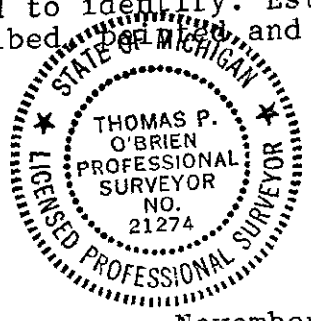

Signed by Thomas P. O'Brien P.S.
 Surveyor's Michigan License No. 21274

Date November 23, 1998