

SCHOOLCRAFT COUNTY PEER GROUP APPROVED

JAN 21 1999

DATE 12/2/98 LAND CORNER RECORDATION CERTIFICATE Filing Requirement of Act 74, Mich. P.A. 1970

SECTION

For corners in

Table with columns: Schoolcraft (County), Located In, Corner Code #. Rows include Public Land Survey, Property Controlling in Section, and Miscellaneous Property in Sec.

SIGRID HEDBERG SCHOOLCRAFT CO. REGISTER 1P Page 1 of 1 LC 4/283 JLO Rec. Date 01/04/99 Time 13:17 REVENUE FEES: 9.00

Register of Deeds Stamp & File Number

4. Lot No. , Recorded Plat 5. Private Claims

I, Thomas P. O'Brien, in a field survey on Dec. 24, 1998 do hereby state that under requirements of P.A. 74, Michigan P.A. of 1970, the corner points mentioned in lines 1 and 2 above were in conformance with regulations and rules therefore as required in the current manual of survey instructions of the United States Department of the Interior, Bureau of Land Management or by a decree of a Court of Law and/or that the corner points mentioned in lines 3, 4 and 5 above were in conformance with the rules of the Michigan Board of Land Surveyors or by a Decree of a Court of Law; established, re-established, monumented, recovered, found as expressed below.

NOTE: Not more than 2 corners, all in the same town and range, may be recorded on this certificate.

Grid table with columns A-M and rows 1-13. Contains numbers 1-36 and a star symbol at row 3, column F.

A. Description of original monument and accessories and/or subsequent restoration:


F3 1/4 corner Sections 4 & 9 Sept. 11, 1845 J. Burt D.S. Set qr. section post Sugar 16 N19W 26 Y. Birch 24 S19E 21

B. Description of corner evidence found and/or method applied in restoring or reestablishing corner:

F3 Dec. 24, 1998 Thomas P. O'Brien, P.S. recovered monumentation from the plat of Erika Shores by Franklyn T. Burgess, R.L.S. 2531 which indicates that the South 1/4 corner of Section 4 is located on the South line of said plat. Measurement of the South line of said plat indicates that subject corner is located under a single story frame building. Set witness monument on South plat line 139.56 feet N85°06'E (Plat Bearing) of corner position. This position is at the intersection of the South plat line with the West line of a Private Road.

C. Description of monument for corner and accessories established to perpetuate locating the position of the corner:

F3 Schoolcraft County monument stamped to identify. Established the following references which have been tagged: 10" Hemlock N45°E 10.60' 8" Maple S22°E 7.58' 8" Maple S54°W 14.96' 12" Maple N25°W 9.60' Carsonite Post North 1.0'

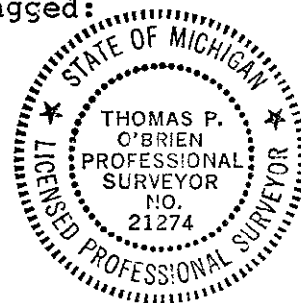

Handwritten signature of Thomas P. O'Brien

Signed by Thomas P. O'Brien, P.S. 21274 Surveyor's Michigan License No. 21274

Date 12/31/98