

JAN 21 1999

SCHOOLCRAFT COUNTY PEER GROUP APPROVED

DATE 12/2/98 JOB LAND CORNER RECORDATION CERTIFICATE Filing Requirement of Act 74, Mich. P.A. 1970

SECTION

For corners in

<u>Schoolcraft</u> (County)	Located In:	Corner Code #
1. Public Land Survey	T41NR 16W	G7
	T R	
	T R	
	T R	
2. Property Controlling in Section	S T R	
	S T R	
3. Miscellaneous Property in Sec.	S T R	
	S T R	

SIGRID HEDBERG 1P
 SCHOOLCRAFT CO. REGISTER LC 4/ 273
 Page 1 of 1
 JLO Rec. Date 12/28/98 Time 15:28
 REVENUE FEES: 9.00

Register of Deeds Stamp & File Number

4. Lot No. _____, Recorded Plat _____
 5. Private Claims _____

I, Thomas P. O'Brien in a field survey on Dec. 14, 1998 do hereby state that under requirements of P.A. 74, Michigan P.A. of 1970, the corner points mentioned in lines 1 and 2 above were in conformance with regulations and rules therefore as required in the current manual of survey instructions of the United States Department of the Interior, Bureau of Land Management or by a decree of a Court of Law and /or that the corner points mentioned in lines 3, 4 and 5 above were in conformance with the rules of the Michigan Board of Land Surveyors or by a Decree of a Court of Law, established, re-established, monumented, recovered, found as expressed below:

NOTE: Not more than 2 corners, all in the same town and range, may be recorded on this certificate.

A	B	C	D	E	F	G	H	I	J	K	L	M
1												
2	6		5		4		3		2		1	
3												
4	7		8		9		10		11		12	
5												
6	18		17		16		15		14		13	
7						X						
8	19		20		21		22		23		24	
9												
10	30		29		28		27		26		25	
11												
12	31		32		33		34		35		36	
13												

A. Description of original monument and accessories and/or subsequent restoration:

G7 NW Corner Section 22, T41N - R16W
 Sept. 12, 1845 - John Burt D.S. set post corner of sections 15,16,21&22
 referenced by: Cedar 9 S64E 12 Cedar 8 N57½W 16
 May 25, 1950 - Carl Christensen County Surveyor set 4' x 2" iron pipe
 with brass cap stamped C.C. from Cedar 9" S64°E 12 links.
 Feb. 21, 1957 - LCRC (L.3 Pg.190) by Billy D. Buckler RLS indicates
 "2" pipe with brass cap, Cedar B.T. bears S63E 12 links. B.T. in
 excellent condition, has been cut off 8' high.


B. Description of corner evidence found and/or method applied in restoring or reestablishing corner:

G7 Dec. 14, 1998 - Thomas P. O'Brien P.S. recovered 2" iron pipe with
 brass cap stamped 15,16,21 and 22 C.C. Buckler B.T. 5" Cedar N26°W 73½
 links, and Cedar B.T. (rotted stump) bearing S63°W - 8.0'±, 8' stub
 with visible upper blaze lying on ground.

C. Description of monument for corner and accessories established to perpetuate locating the position of the corner:

G7 4' x 2" iron pipe with brass cap stamped to identify. Established
 the following references which have been blazed, scribed, painted
 and tagged:

- 10" Cedar - N26°W - 48.15' (measured to face of blaze)
- 8" Cedar - N50°E - 15.65'
- 5" Cedar - S60°E - 19.74'
- 10" Cedar - S74°W - 77.0'
- Carsonite post - North - 1.0'

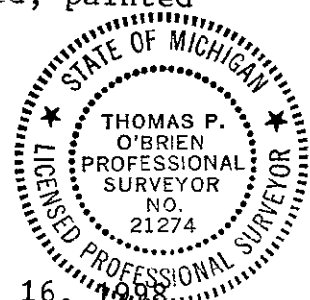

Signed by Thomas P. O'Brien
 Surveyor's Michigan License No. 21274

Date December 16, 1998