

SCHOOLCRAFT COUNTY PEER GROUP APPROVED

DATE 10/15/97

LAND CORNER RECORDATION CERTIFICATE
Filing Requirement of Act 74, Mich. P.A. 1970

SURVEY &
REMONUMENTATION

JAN 21 1998

For corners in

Schoolcraft (County)	Located In:	Corner Code #
1. Public Land Survey	T42NR16W T41N RI6W T___R___ T___R___	I-13 I-1
2. Property Controlling in Section	S___T___R___ S___T___R___	_____
3. Miscellaneous Property in Sec.	S___T___R___ S___T___R___	_____

SECTION 9
Received & Filed this 9 day of
December 1997 at 3:50 PM
Sigrid I. Hedberg
Schoolcraft Co. Reg. of Deeds

Register of Deeds Stamp & File Number

4. Lot No. _____, Recorded Plat _____
5. Private Claims _____

Thomas P. O'Brien in a field survey on Oct. 29, 1997 do hereby state that under requirements of P.A. 74, Michigan P.A. of 1970, the corner points mentioned in lines 1 and 2 above were in conformance with regulations and rules therefore as required in the current manual of survey instructions of the United States Department of the Interior, Bureau of Land Management or by a decree of a Court of Law and /or that the corner points mentioned in lines 3, 4 and 5 above were in conformance with the rules of the Michigan Board of Land Surveyors or by a Decree of a Court of Law; established, re-established, monumented, recovered, found as expressed below:

NOTE: Not more than 2 corners, all in the same town and range, may be recorded on this certificate.

1	A	B	C	D	E	F	G	H	I	J	K	L	M
2	6		5		4		3		2		1		
3													
4	7		8		9		10		11		12		
5													
6	18		17		16		15		14		13		
7													
8	19		20		21		22		23		24		
9													
10	30		29		28		27		26		25		
11													
12	31		32		33		34		35		36		
13													

A. Description of original monument and accessories and/or subsequent restoration:

I-13 SW Corner Section 35
Aug. 4, 1845 - John Burt D.S. set corner post.
Aspen 6 N 79½ E 1.40 Y. Pine 5 N 30½ W 1.19

March 8, 1976 - Thomas P. O'Brien P.S. "found T iron."


B. Description of corner evidence found and/or method applied in restoring or reestablishing corner:

I-13 Oct. 29, 1997 - Thomas P. O'Brien P.S. recovered a "T" iron in black top road over old wood post, also found a 1½" iron pinch pipe along side of wood post. Witness found verifies corner location as found by Thomas P. O'Brien P.S. on March 8, 1976. Replaced "T" iron with I.B. and O'Brien cap #21274 in monument box.

C. Description of monument for corner and accessories established to perpetuate locating the position of the corner:

I-13 1/2" Iron bar with O'Brien cap # 21274 in monument box.

Witnesses: (Fd.) 4" Cedar - North - 37.30'
Power Pole - S73°E - 120.98'
Power Pole - S57°W - 49.88'
12" R. Pine - N19°W - 60.88'
4" Cedar Post - North - 30.0'

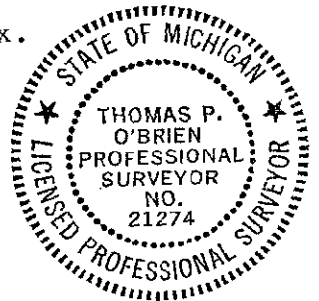

Signed by Thomas P. O'Brien P.S.
Surveyor's Michigan License No. 21274

Date November 26, 1997

LEIGH 4 PAGE: 131