

JAN 21 1999

SCHOOLCRAFT COUNTY PEER GROUP APPROVED

DATE 12/2/98 JOB

LAND CORNER RECORDATION CERTIFICATE

SECTION

For corners in

Filing Requirement of Act 74, Mich. P.A. 1970

STEFAN HEBBERG SCHOOLCRAFT CO. REGISTER 1P Page 1 of 1 JLO Rec. Date 12/15/98 LC 4/237 REVENUE FEES: Time 14:19 9.00

Schoolcraft (County)	Located In:	Corner Code #
1. Public Land Survey	T41NR16W	I6
	T R	
	T R	
	T R	
2. Property Controlling in Section	S T R	
	S T R	
3. Miscellaneous Property in Sec.	S T R	
	S T R	

Register of Deeds Stamp & File Number

4. Lot No. , Recorded Plat
5. Private Claims

Thomas P. O'Brien in a field survey on Dec 11, 1998 do hereby state that under requirements of P.A. 74, Michigan P.A. of 1970, the corner points mentioned in lines 1 and 2 above were in conformance with regulations and rules therefore as required in the current manual of survey instructions of the United States Department of the Interior, Bureau of Land Management or by a decree of a Court of Law and /or that the corner points mentioned in lines 3, 4 and 5 above were in conformance with the rules of the Michigan Board of Land Surveyors or by a Decree of a Court of Law, established, re-established, monumented, recovered, found as expressed below.

NOTE: Not more than 2 corners, all in the same town and range, may be recorded on this certificate.

	A	B	C	D	E	F	G	H	I	J	K	L	M
1													
2	6		5		4		3		2		1		
3													
4	7		8		9		10		11		12		
5													
6	18		17		16		15		14		13		
7													
8	19		20		21		22		23		24		
9													
10	30		29		28		27		26		25		
11													
12	31		32		33		34		35		36		
13													

A. Description of original monument and accessories and/or subsequent restoration:
I6 W 1/4 Corner Section 14, T41N - R16W
Sept. 11, 1845 - John Burt D.S. set qr. section post referenced by:
Y. Pine 24 N7E 34 Y. Pine 16 N26W 22


B. Description of corner evidence found and/or method applied in restoring or reestablishing corner:
I6 Dec. 11, 1998 - Thomas P. O'Brien P.S. recovered 1 1/2" x 4' iron pipe with scribed witnesses. Reset iron pipe with Schoolcraft County Monument stamped to identify.

C. Description of monument for corner and accessories established to perpetuate locating the position of the corner:
I6 Schoolcraft County Monument stamped to identify. Repainted blazes on NBT's and made measurements to the following references:

- 8" Twin Maple - N53°E - 68.91'
- 30" W. Pine - S45°E - 96.48'
- 8" W. Pine - S88°W - 31.06'
- 18" W. Pine - N 7°W - 55.68'
- Carsonite post - North - 1.0'

Thomas P. O'Brien

Signed by Thomas P. O'Brien
Surveyor's Michigan License No. 21274

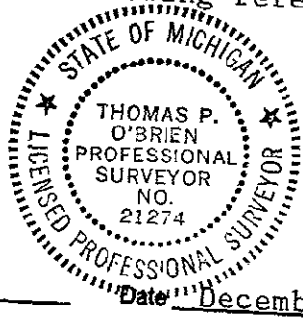

Date December 14, 1998