

SCHOOLCRAFT COUNTY  
PEER GROUP APPROVED

SURVEY &  
REMONUMENTATION

JAN 21 1998

DATE 10/15/97

LAND CORNER RECORDATION CERTIFICATE  
Filing Requirement of Act 74, Mich. P.A. 1970

SECTION

For corners in

<u>Schoolcraft</u> (County)	Located In:	Corner Code #
1. Public Land Survey	T42NR16W T41N R16W T___ R___ T___ R___	J-13 <u>J-1</u> ✓
2. Property Controlling In Section	S___ T___ R___ S___ T___ R___	_____
3. Miscellaneous Property in Sec.	S___ T___ R___ S___ T___ R___	_____

Received & Filed this 9 day of  
Dec. 1997 at 3:14 P M  
Sigrid I. Hedberg  
Schoolcraft Co. Reg. of Deeds

Register of Deeds Stamp & File Number

4. Lot No. \_\_\_\_\_, Recorded Plat \_\_\_\_\_  
5. Private Claims \_\_\_\_\_

I, Thomas P. O'Brien in a field survey on Oct. 29, 1997 do hereby state that under requirements of P.A. 74, Michigan P.A. of 1970, the corner points mentioned in lines 1 and 2 above were in conformance with regulations and rules therefore as required in the current manual of survey instructions of the United States Department of the Interior, Bureau of Land Management or by a decree of a Court of Law and /or that the corner points mentioned in lines 3, 4 and 5 above were in conformance with the rules of the Michigan Board of Land Surveyors or by a Decree of a Court of Law; established, re-established, monumented, recovered, found as expressed below:

A	B	C	D	E	F	G	H	I	J	K	L	M
1												
2	6		5		4		3		2		1	
3												
4	7		8		9		10		11		12	
5												
6	18		17		16		15		14		13	
7												
8	19		20		21		22		23		24	
9												
10	30		29		28		27		26		25	
11												
12	31		32		33		34		35		36	
13												

NOTE: Not more than 2 corners, all in the same town and range, may be recorded on this certificate.

A. Description of original monument and accessories and/or subsequent restoration:


J-13 S 1/4 Corner Section 35  
Aug. 4, 1845 - John Burt D.S. set qr. section post.  
Sugar 8 N38E 39 Cedar 8 N35W 39  
  
Jan. 4, 1974 - John R. Radcliffe fd. 1 1/2" pipe on fence line.  
LCRC recoded Liber 1, page 22.  
  
Sept. 19, 1985 - Neil E. Hill R.L.S. fd. 1 1/4" pipe on fence line.  
LCRC recoded Liber 2, page 203.

B. Description of corner evidence found and/or method applied in restoring or reestablishing corner:

J-13 Oct. 29, 1997 - Thomas P. O'Brien P.S. recovered a 1 1/4" iron pipe on fence line. Witnesses found verify corner location. Replaced pipe with Schoolcraft County Monument.

C. Description of monument for corner and accessories established to perpetuate locating the position of the corner:

J-13 Schoolcraft County Monument stamped to identify.  
Witnesses: (Fd.) 16" Maple-S80°W - 35.08'  
(Fd.) 15" Maple-N80°W - 15.23'  
(Fd.) 13" Maple-N85°W - 49.48'  
(Fd.) Fence Post - West - 1.05'  
(Fd.) Fence Post - S65°E - 13.0'  
(Fd.) Fence Post - S58°W - 10.80'  
4" Cedar post - North - 2.0'

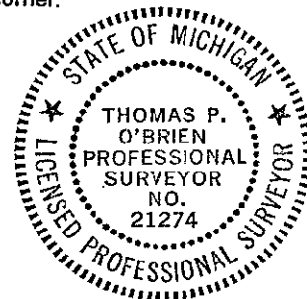

Signed by Thomas P. O'Brien  
Thomas P. O'Brien P.S.  
Surveyor's Michigan License No. 21274

Date November 28, 1997

LIBER 4 PAGE: 125