

SCHOOLCRAFT COUNTY
PEER REVIEW APPROVED

SURVEY &
REMONUMENTATION

JAN 21 1999

DATE 12/2/98 JPB

LAND CORNER RECORDATION CERTIFICATE
Filing Requirement of Act 74, Mich. P.A. 1970

SECTION

For corners in

Schoolcraft (County)	Located In:	Corner Code #
1. Public Land Survey	T41NR16W	K 2
	T___R___	_____
	T___R___	_____
	T___R___	_____
2. Property Controlling in Section	S___T___R___	_____
	S___T___R___	_____
3. Miscellaneous Property in Sec.	S___T___R___	_____
	S___T___R___	_____

SIGRID HEDBERG 1P
SCHOOLCRAFT CO. REGISTER LC 4/ 278
Page 1 of 1
JLO Rec. Date 12/28/98 Time 15:29
REVENUE FEES: 9.00

Register of Deeds Stamp & File Number

4. Lot No. _____, Recorded Plat _____
5. Private Claims _____

Thomas P. O'Brien, in a field survey on Dec. 9, 1998 do hereby state that under requirements of P.A. 74, Michigan P.A. of 1970, the corner points mentioned in lines 1 and 2 above were in conformance with regulations and rules therefore as required in the current manual of survey instructions of the United States Department of the Interior, Bureau of Land Management or by a decree of a Court of Law and /or that the corner points mentioned in lines 3, 4 and 5 above were in conformance with the rules of the Michigan Board of Land Surveyors or by a Decree of a Court of Law, established, re-established, monumented, recovered, found as expressed below:

NOTE: Not more than 2 corners, all in the same town and range, may be recorded on this certificate.

	A	B	C	D	E	F	G	H	I	J	K	L	M
1													
2	6		5		4		3		2	X	1		
3													
4	7		8		9		10		11		12		
5													
6	18		17		16		15		14		13		
7													
8	19		20		21		22		23		24		
9													
10	30		29		28		27		26		25		
11													
12	31		32		33		34		35		36		
13													

A. Description of original monument and accessories and/or subsequent restoration:

K2 W 1/4 Coner Section 1, T41N - R16W
Sept. 10, 1845 - John Burt D.S. set qr. section post referenced by:
Y. Pine 16 N55W 24 Y. Pine 15 S14W 47

June 22, 1977 - LCRC (L.1 Pg.161) by Herbert L. Fluharty RLS indicates " Fd. 1 1/2" pipe that was pulled out and upon resetting according to the plat to the North we found the original hole where it was set originally - reset 4' x 1 1/2" pipe in original hole (on centerline of E - W cleared R/W."


B. Description of corner evidence found and/or method applied in restoring or reestablishing corner:

K2 Dec. 9, 1998 - Thomas P. O'Brien P.S. recovered 4' x 1 1/2" iron pipe with existing witnesses that verify corner location as found by Fluharty on June 22, 1977. Reset iron pipe with Schoolcraft County Monument stamped to identify.

C. Description of monument for corner and accessories established to perpetuate locating the position of the corner:

K2 Schoolcraft County Monument stamped to identify. Established the following references which have been blazed, scribed, painted and tagged:

- 10" R. Pine - N33°W - 120.33'
- 10" R. Pine - N25°E - 121.15'
- 10" W. Pine - S22°E - 118.65'
- 10" W. Pine - S 5°E - 99.33'
- 1 1/2" x 4' iron pipe - S7°E - 17.70'
- 10" Spruce - S30°W - 34.90' (cut stump lower blaze and nail)
- Carsonite post - North - 1.0'

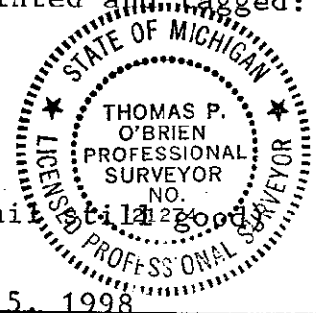

Signed by Thomas P. O'Brien
Surveyor's Michigan License No. 21274

Date December 15, 1998