

JAN 21 1999

SCHOOLCRAFT COUNTY
PEER GROUP APPROVED

DATE 12/2/98 OB LAND CORNER RECORDATION CERTIFICATE
Filing Requirement of Act 74, Mich. P.A. 1970

SECTION

For corners in

<u>Schoolcraft</u> (County)	Located In:	Corner Code #
1. Public Land Survey	T41NR16W	<u>M4</u> ✓
	T41NR15W	<u>A4</u>
	T___R___	_____
	T___R___	_____
2. Property Controlling in Section	S___T___R___	_____
	S___T___R___	_____
3. Miscellaneous Property in Sec.	S___T___R___	_____
	S___T___R___	_____

SIGRID HEDBERG
SCHOOLCRAFT CO. REGISTER 1P
Page 1 of 1 LC 4/ 245
JLO Rec. Date 12/15/98 Time 14:24
REVENUE FEES: 9.00

SURVEY &
REMONUMENTATION
MAR 03 1999

Register of Deeds Stamp & File Number

4. Lot No. _____, Recorded Plat _____
5. Private Claims _____

SECTION

Thomas P. O'Brien in a field survey on Dec. 3, 1998 do hereby state that under requirements of P.A. 74, Michigan P.A. of 1970, the corner points mentioned in lines 1 and 2 above were in conformance with regulations and rules therefore as required in the current manual of survey instructions of the United States Department of the Interior, Bureau of Land Management or by a decree of a Court of Law and/or that the corner points mentioned in lines 3, 4 and 5 above were in conformance with the rules of the Michigan Board of Land Surveyors or by a Decree of a Court of Law; established, re-established, monumented, recovered, found as expressed below.

	A	B	C	D	E	F	G	H	I	J	K	L	M
1													
2	6		5		4		3		2		1		
3													
4	7		8		9		10		11		12		X
5													
6	18		17		16		15		14		13		
7													
8	19		20		21		22		23		24		
9													
10	30		29		28		27		26		25		
11													
12	31		32		33		34		35		36		
13													

NOTE: Not more than 2 corners, all in the same town and range, may be recorded on this certificate.

A. Description of original monument and accessories and/or subsequent restoration:

M4 E 1/4 Corner Section 12, T41N - R16W
1845 - John Burt D.S. set qr. section post common to section 12
T41N - R16W and section 7 T41N - R15W, referenced by:
Hemlock 7 N52W 22 Hemlock 8 S59W 5

June 22, 1989 - LCRC (L.2 Pg. 218) by Gerald W. Carlson P.S. 24589 indicates he " Found 1/2" rerod with L.L.S. cap no. 28406 and 5/8" rerod along side inside ball diamond fence."


B. Description of corner evidence found and/or method applied in restoring or reestablishing corner:

M4 Dec. 3, 1998 - Thomas P. O'Brien P.S. recovered 1/2" rerod with RLS cap 28406 and 5/8" rod alongside. Accepted 1/2" rerod with 28406 cap, existing witnesses found verify corner location as found by Gerald W. Carlson P.S. on June 22, 1989. Replaced 1/2" rerod with Schoolcraft County Monument stamped to identify.

C. Description of monument for corner and accessories established to perpetuate locating the position of the corner:

M4 Schoolcraft County Monument stamped to identify. Made measurements to the following references:

- (Fd.) SW corner fence post of ball field - S37°W - 36.0'
- (Fd.) 4th post North of corner post - N45°W - 1.82'
- (Fd.) 7th post North of corner post - N31°E - 31.23'
- (Fd.) 3rd post East of corner post - S8°E - 53.24'
- Carsonite post - West - 2.0'

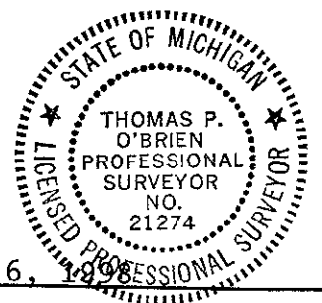

Thomas P. O'Brien

Signed by Thomas P. O'Brien

Date December 6, 1998

Surveyor's Michigan License No. 21274