

**SCHOOLCRAFT COUNTY  
PEER GROUP APPROVED**

**SURVEY &  
REMONUMENTATION**

DATE 10/21/98 JOB LAND CORNER RECORDATION CERTIFICATE  
Filing Requirement of Act 74, Mich. P.A. 1970

JAN 21 1999

For corners in

SECTION

Schoolcraft Located In: Corner Code #  
(County)

- |                                    |  |     |
|------------------------------------|--|-----|
| 1. Public Land Survey              | T <u>41</u> N <u>16</u> W              | A-2 |
|                                    | T <u>41</u> N <u>17</u> W              | M-2 |
|                                    | T <u>   </u> R <u>   </u>              |     |
|                                    | T <u>   </u> R <u>   </u>              |     |
| 2. Property Controlling in Section | S <u>   </u> T <u>   </u> R <u>   </u> |     |
|                                    | S <u>   </u> T <u>   </u> R <u>   </u> |     |
| 3. Miscellaneous Property in Sec.  | S <u>   </u> T <u>   </u> R <u>   </u> |     |
|                                    | S <u>   </u> T <u>   </u> R <u>   </u> |     |

SIGRID HEDBERG 1P  
SCHOOLCRAFT CO. REGISTER  
Page 1 of 1 LC 4/207  
JLO Rec. Date 12/03/98 Time 14:25  
REVENUE FEES: 9.00

Register of Deeds Stamp & File Number

4. Lot No. \_\_\_\_\_, Recorded Plat \_\_\_\_\_  
5. Private Claims \_\_\_\_\_

	A	B	C	D	E	F	G	H	I	J	K	L	M
1													
2	6		5		4		3		2		1		
3													
4	7		8		9		10		11		12		
5													
6	18		17		16		15		14		13		
7													
8	19		20		21		22		23		24		
9													
10	30		29		28		27		26		25		
11													
12	31		32		33		34		35		36		
13													

I, Thomas P. O'Brien in a field survey on Oct. 22, 1998 do hereby state that under requirements of P.A. 74, Michigan P.A. of 1970, the corner points mentioned in lines 1 and 2 above were in conformance with regulations and rules therefore as required in the current manual of survey instructions of the United States Department of the Interior, Bureau of Land Management or by a decree of a Court of Law and/or that the corner points mentioned in lines 3, 4 and 5 above were in conformance with the rules of the Michigan Board of Land Surveyors or by a Decree of a Court of Law; established, re-established, monumented, recovered, found as expressed below:

NOTE: Not more than 2 corners, all in the same town and range, may be recorded on this certificate.

A. Description of original monument and accessories and/or subsequent restoration:

A2 W 1/4 Corner Section 6, T41N - R16W  
July 29, 1845 - John Burt D.S. set qr. section post common to section 6, T41N - R16W and section 1, T41N - R17W.

June 23, 1970 ± L.C.R.C. by Frank J. Bray (L.3 Pg.399 RLS) indicates "This corner was rewitnessed as set by unknown party. Corner has been accepted by adjoining landowners".


B. Description of corner evidence found and/or method applied in restoring or reestablishing corner:

A2 Oct. 22, 1998 - Thomas P. O'Brien P.S. recovered iron rod buried below black top surface .30'. Replaced iron rod with I.B. and O'Brien cap # 21274 in Monument Box. Existing BT verifies corner location as found by Frank J. Bray on June 23, 1970.

C. Description of monument for corner and accessories established to perpetuate locating the position of the corner:

A2 I.B. with O'Brien cap # 21274 set in Monument Box. Established the following references which are blazed, scribed, painted and tagged:

- (Fd.) 18" Beech - S65°E - 52.90'
- NBT 8" Maple - S57°W - 91.98'
- NBT 8" Maple - N32°W - 110.81'
- SW corner of brick house - N58°E - 79.62'
- Centerline of Gravel Rd. East - North - 6.0'
- Centerline of County Rd. 455 - West - 15.30'

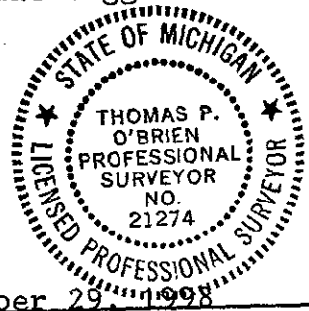

Signed by Thomas P. O'Brien  
Surveyor's Michigan License No. 21274

Date November 29, 1998