

**SCHOOLCRAFT COUNTY
PEER GROUP APPROVED**

**SURVEY &
REMONUMENTATION**

JAN 21 1999

DATE 10/21/98 JOB

LAND CORNER RECORDATION CERTIFICATE
Filing Requirement of Act 74, Mich. P.A. 1970

SECTION _____

For corners in

Schoolcraft Located In: _____ Corner Code # _____
(County)

- 1. Public Land Survey T41NR16W A-6
- T41NR17W / M-6
- T _____ R _____
- T _____ R _____
- 2. Property Controlling S _____ T _____ R _____
- In Section S _____ T _____ R _____
- 3. Miscellaneous S _____ T _____ R _____
- Property in Sec. S _____ T _____ R _____

SIGRID HEDBERG 1P
SCHOOLCRAFT CO. REGISTER
Page 1 of 1 LC 4/ 211
JLO Red. Date 12/03/98 Time 14:27
REVENUE FEES: 9.00

Register of Deeds Stamp & File Number

- 4. Lot No. _____, Recorded Plat _____
- 5. Private Claims _____

	A	B	C	D	E	F	G	H	I	J	K	L	M
1													
2	6		5		4		3		2		1		
3													
4	7		8		9		10		11		12		
5													
6	18		17		16		15		14		13		
7													
8	19		20		21		22		23		24		
9													
10	30		29		28		27		26		25		
11													
12	31		32		33		34		35		36		
13													

Thomas P. O'Brien, in a field survey on Oct. 23, 1998 do hereby state that under requirements of P.A. 74, Michigan P.A. of 1970, the corner points mentioned in lines 1 and 2 above were in conformance with regulations and rules therefore as required in the current manual of survey instructions of the United States Department of the Interior, Bureau of Land Management or by a decree of a Court of Law and/or that the corner points mentioned in lines 3, 4 and 5 above were in conformance with the rules of the Michigan Board of Land Surveyors or by a Decree of a Court of Law; established, re-established, monumented, recovered, found as expressed below:

NOTE: Not more than 2 corners, all in the same town and range, may be recorded on this certificate.

A. Description of original monument and accessories and/or subsequent restoration:


A6 W 1/4 Corner Section 18, T41N - R16W
July 29, 1845 - John Burt D.S. set qr. section post common to section 18, T41N - R16W and section 13, T41N - R17W, referenced by:
Hemlock 20 S55W 39 Beech 5 N57W 58

B. Description of corner evidence found and/or method applied in restoring or reestablishing corner:

A6 Oct. 23, 1998 - Thomas P. O'Brien P.S. recovered I.B. with cap LS 28406 and replaced I.B. with Schoolcraft County Monument stamped to identify. Distances North & South indicate corner was set by single proportionate measurement between A-5 & A-7.

C. Description of monument for corner and accessories established to perpetuate locating the position of the corner:

A6 Schoolcraft County Monument stamped to identify. Established the following references which are blazed, scribed, painted and tagged:
NBT 8" Maple - N83°W - 129.37'
NBT 8" Maple - N48°W - 95.57'
NBT 10' R. Pine - N34°E - 169.0'
NBT 12" R. Pine - S63°E - 41.26'
Centerline Co. Rd. 455 - West - 14.60'
Carsonite post - East - 20.0'

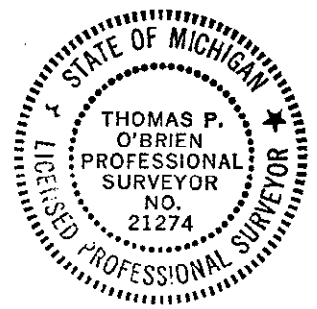

Thomas P. O'Brien

Signed by Thomas P. O'Brien

Date November 29, 1998

Surveyor's Michigan License No. 21274