

JAN 21 1999

SCHOOLCRAFT COUNTY
PEER GROUP APPROVED

DATE 10/21/98 ^{JOB} LAND CORNER RECORDATION CERTIFICATE
Filing Requirement of Act 74, Mich. P.A. 1970

SECTION

For corners in

<u>Schoolcraft</u> (County)	Located In:	Corner Code #
1. Public Land Survey	T41NR16W T41NR17W	A-9 M-9 ✓
	T ___ R ___	_____
	T ___ R ___	_____
2. Property Controlling in Section	S ___ T ___ R ___	_____
	S ___ T ___ R ___	_____
3. Miscellaneous Property in Sec.	S ___ T ___ R ___	_____
	S ___ T ___ R ___	_____

SIGRID HEDBERG 1P
SCHOOLCRAFT CO. REGISTER
Page 1 of 1 LC 4/ 214
JLO Rec. Date 12/03/98 Time 14:28
REVENUE FEES: 9.00

Register of Deeds Stamp & File Number

4. Lot No. _____, Recorded Plat _____
5. Private Claims _____

Thomas P. O'Brien in a field survey on Nov. 25, 1998 do hereby state that under requirements of P.A. 74, Michigan P.A. of 1970, the corner points mentioned in lines 1 and 2 above were in conformance with regulations and rules therefore as required in the current manual of survey instructions of the United States Department of the Interior, Bureau of Land Management or by a decree of a Court of Law and/or that the corner points mentioned in lines 3, 4 and 5 above were in conformance with the rules of the Michigan Board of Land Surveyors or by a Decree of a Court of Law; established, re-established, monumented, recovered, found as expressed below:

NOTE: Not more than 2 corners, all in the same town and range, may be recorded on this certificate.

A	B	C	D	E	F	G	H	I	J	K	L	M
1												
2	6	5	4	3	2	1						
3												
4	7	8	9	10	11	12						
5												
6	18	17	16	15	14	13						
7												
8	19	20	21	22	23	24						
9												
10	30	29	28	27	26	25						
11												
12	31	32	33	34	35	36						
13												

A. Description of original monument and accessories and/or subsequent restoration:

A9 NW Corner Section 30, T41N - R16W
July 29, 1845 - John Burt D.S. set post corner of sections 19 & 30
T41N - R16W and sections 24 & 25 T41N - R17W, referenced by :
Spruce Pine - 7 S 60 W 13 Y. Pine - 20 N 30 W 28


B. Description of corner evidence found and/or method applied in restoring or reestablishing corner:

A9 Nov. 25, 1998 - Thomas P. O'Brien P.S. reestablished corner by single proportionate measurement between A-7 and A-11. Set Schoolcraft County Monument stamped to identify.

C. Description of monument for corner and accessories established to perpetuate locating the position of the corner:

A9 Schoolcraft County Monument stamped to identify. Established the following references which are blazed, scribed, painted and tagged:

- NBT - 10" J. Pine - N31°W - 90.86'
- NBT - 6" J. Pine - N28°E - 58.80'
- NBT - 3" R. Pine - S13°E - 27.30'
- NBT - 4" R. Pine - S34°W - 48.90'
- Carsonite post - North - 1.0'

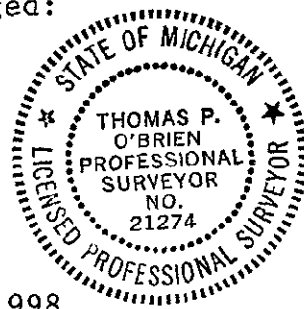

Signed by Thomas P. O'Brien
Surveyor's Michigan License No. 21274

Date November 29, 1998