

**SCHOOLCRAFT COUNTY
PEER GROUP APPROVED**

DATE 10/21/98 JOB

SURVEY &
REMONUMENTATION

JAN 21 1999

**LAND CORNER RECORDATION CERTIFICATE
Filing Requirement of Act 74, Mich. P.A. 1970**

SECTION

For corners in

<u>Schoolcraft</u> (County)	Located In:	Corner Code #
1. Public Land Survey	T <u>41</u> N <u>16</u> W	A-10
	T <u>41</u> N <u>17</u> W	M-10 ✓
	T ___ R ___	___
	T ___ R ___	___
2. Property Controlling in Section	S ___ T ___ R ___	___
	S ___ T ___ R ___	___
3. Miscellaneous Property in Sec.	S ___ T ___ R ___	___
	S ___ T ___ R ___	___

SIGRID HEDBERG
Page 1 of 1
JLO Rec. Date 12/03/98 Time 14:28
REVENUE FEES: 9.00
SCHOOLCRAFT CO. REGISTER 1P
LC 4/215

Register of Deeds Stamp & File Number

4. Lot No. _____, Recorded Plat _____
5. Private Claims _____

I, Thomas P. O'Brien in a field survey on Oct. 26, 1998 do hereby state that under requirements of P.A. 74, Michigan P.A. of 1970, the corner points mentioned in lines 1 and 2 above were in conformance with regulations and rules therefore as required in the current manual of survey instructions of the United States Department of the Interior, Bureau of Land Management or by a decree of a Court of Law and /or that the corner points mentioned in lines 3, 4 and 5 above were in conformance with the rules of the Michigan Board of Land Surveyors or by a Decree of a Court of Law; established, re-established, monumented, recovered, found as expressed below:

NOTE: Not more than 2 corners, all in the same town and range, may be recorded on this certificate.

1	A	B	C	D	E	F	G	H	I	J	K	L	M
2	6		5		4		3		2		1		
3													
4	7		8		9		10		11		12		
5													
6	18		17		16		15		14		13		
7													
8	19		20		21		22		23		24		
9													
10	30		29		28		27		26		25		
11													
12	31		32		33		34		35		36		
13													

A. Description of original monument and accessories and/or subsequent restoration:


A10 W 1/4 Corner Section 30, T41N - R16W
July 29, 1845 - John Burt D.S. set qr. section post, referenced by:
Cedar 6 S44W 20 Hemlock 8 N44W 50

B. Description of corner evidence found and/or method applied in restoring or reestablishing corner:

A10 Oct. 26 1998 - Thomas P. O'Brien P.S. reestablished corner by single proportionate measurement between A-7 & A-11.

C. Description of monument for corner and accessories established to perpetuate locating the position of the corner:

A10 Schoolcraft County Monument stamped to identify. Established the following references which are blazed, scribed, painted and tagged:
NBT 10" Maple - N22°W - 48.75'
NBT 8" Maple - N53°E - 9.32'
NBT 10" Maple - S27°E - 25.42'
NBT 8" Maple - S53°W - 39.10'
Carsonite post - North - 1.0'

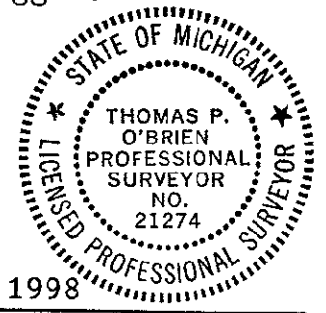

Thomas P. O'Brien

Signed by Thomas P. O'Brien
Surveyor's Michigan License No. 21274

Date November 29, 1998