

**SCHOOLCRAFT COUNTY
PEER GROUP APPROVED**

DATE 11/8/99 JUB

LAND CORNER RECORDATION CERTIFICATE
Filing Requirement of Act 74, Mich. P.A. 1970

RE...

JAN 25 2000

SECTION

For corners in

Schoolcraft
(County)

Located in:

Corner Code #

1. Public Land Survey

T 41NR15W

B5

T R

T R

T R

2. Property Controlling
in Section

S T R

S T R

3. Miscellaneous
Property in Sec.

S T R

S T R

SIGRID HEDBERG
SCHOOLCRAFT CO. REGISTER 1P
Page 1 of 1
JLV Date 12/22/1999 LC 4/295
RECORDING FEES: Time 13:50:44
9.00

Register of Deeds Stamp & File Number

4. Lot No. , Recorded Plat

5. Private Claims

	A	B	C	D	E	F	G	H	I	J	K	L	M
1													
2	6		5		4		3		2		1		
3													
4	7		8		9		10		11		12		
5													
6	18		17		16		15		14		13		
7													
8	19		20		21		22		23		24		
9													
10	30		29		28		27		26		25		
11													
12	31		32		33		34		35		36		
13													

I, Thomas P. O'Brien in a field survey on Nov. 22, 1999 do hereby state that under requirements of P.A. 74, Michigan P.A. of 1970, the corner points mentioned in lines 1 and 2 above were in conformance with regulations and rules therefore as required in the current manual of survey instructions of the United States Department of the Interior, Bureau of Land Management or by a decree of a Court of Law and/or that the corner points mentioned in lines 3, 4 and 5 above were in conformance with the rules of the Michigan Board of Land Surveyors or by a Decree of a Court of Law; established, re-established, monumented, recovered, found as expressed below:

NOTE: Not more than 2 corners, all in the same town and range, may be recorded on this certificate.

A. Description of original monument and accessories and/or subsequent restoration:

Sept. 9, 1845
J. Burt; DS set qr. section post Tamarack 3 S3½E 36 Cedar 3 N30E 30

Oct. 24, 1979 John P. Smallwood, RLS found rail road spike located by previous surveyor.
Placed monument box with ½" copper clad rod with RLS 16944 cap.

1989 Thomas P. O'Brien, PS witnessed point and replace monument box after road resurfacing.

B. Description of corner evidence found and/or method applied in restoring or reestablishing corner:

Nov. 22, 1999 Thomas P. O'Brien, PS found monument box w/RLS 21274 cap.

C. Description of monument for corner and accessories established to perpetuate locating the position of the corner:

½" iron bar w/RLS 21274 cap in monument box.

Witnesses:

6" Twin Cedar N7°W 54.4'


Power Pole N46°W 35.6'

NE House Corner S46°W 78.35'

SW Garage Corner N13°E 60.55'

NW Corner House Foundation S41°E 99.5'

Carsonite Post North 20.0'

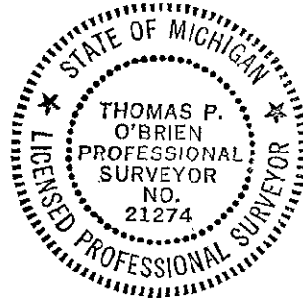

Signed by Thomas P. O'Brien

Surveyor's Michigan License No. 21274

Date Dec. 16, 1999