

**SCHOOLCRAFT COUNTY  
PEER GROUP APPROVED**

SCHOOLCRAFT COUNTY  
REGISTRATION

JAN 30 1996

**DATE** May 12, 1995 **LAND CORNER RECORDATION CERTIFICATE**

**COMMISSION**

**Filing Requirement of Act 74, Mich. P.A. 1970**

For corners in

<u>Schoolcraft</u> (County)	Located In:	Corner Code #
1. Public Land Survey	T <u>42 N</u> R <u>15 W</u>	<u>C-13</u>
	T <u>41 N</u> R <u>15 W</u>	<u>C-1</u> ✓
	T _____ R _____	_____
	T _____ R _____	_____
2. Property Controlling in Section	S _____ T _____ R _____	_____
	S _____ T _____ R _____	_____
3. Miscellaneous Property in Sec.	S _____ T _____ R _____	_____
	S _____ T _____ R _____	_____

Received & Filed this 6 day of  
Dec. 1995 at 11:46 AM  
Sigrid I. Hedberg  
Schoolcraft Co. Reg. of Deeds

Register of Deeds Stamp & File Number

4. Lot No. \_\_\_\_\_, Recorded Plat \_\_\_\_\_  
5. Private Claims \_\_\_\_\_

A	B	C	D	E	F	G	H	I	J	K	L	M
2	6	5	4	3	2	1						
3												
4	7	8	9	10	11	12						
5												
6	18	17	16	15	14	13						
7												
8	19	20	21	22	23	24						
9												
10	30	29	28	27	26	25						
11												
12	31	32	33	34	35	36						
13		X										

I, Thomas P. O'Brien, in a field survey on Oct. 6, 19 95, do hereby certify that under requirements of P.A. 74, Michigan P.A. of 1970, the corner points mentioned in lines 1 and 2 above were in conformance with regulations and rules therefore as required in the current manual of survey instructions of the United States Department of the Interior, Bureau of Land Management or by a decree of a Court of Law and/or that the corner points mentioned in lines 3, 4 and 5 above were in conformance with the rules of the Michigan Board of Land Surveyors or by a Decree of a Court of Law; established, re-established, monumented, re-monumented, recovered, found as expressed below:

**NOTE: Not more than 4 corners, all in the same town and range, may be recorded on this certificate.**

A. Description of original monument and accessories and/or subsequent restoration:


C-13 ( S.E. Corner Sec. 31)  
Aug. 6, 1845 John Burt D.S. set corner post.  
Spruce 4 N34W 31 do 4 N39E 15  
  
Sept. 9/45 John Burt D.S. South between sections 5&6  
Spruce 4 S44W 4 Cedar 3 S50E 5

B. Description of corner evidence found and/or method applied in restoring or reestablishing corner:

C-13 Jan. 8, 1957 Billy D. Buckler, RLS found 2" iron pipe with 2½" Brass cap, set by Carl Christensen from "3" Cedar B.T. S50E 5 links."  
  
Oct, 19, 1994 Thomas P. O'Brien, PS recovered iron pipe w/brass cap set by Carl Christensen from original bearing tree "Cedar 3" S50E 5 links" as noted in County Surveyors book.

C. Description of monument for corner and accessories established to perpetuate locating the position of the corner:

C-13 2" iron pipe w|2½" brass cap stamped to identify by "CC"  
Witnesses:  
8"cedar N30°W 25.70'  
18"Cedar N84°E 20.40'  
18"Cedar S60°E 10.75'  
16"Cedar S66°W 19.10'

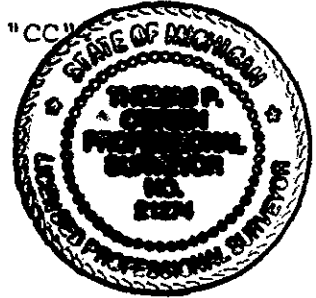

Signed by Thomas P. O'Brien, PS Date Dec. 4, 1995

Surveyor's Michigan License No. 21274