

**SCHOOLCRAFT COUNTY
PEER GROUP APPROVED**

JAN 30 1996
COMMISSION

DATE May 12, 1995 LAND CORNER RECORDATION CERTIFICATE
Filing Requirement of Act 74, Mich. P.A. 1970

For corners in

<u>Schoolcraft</u> (County)	Located In:	Corner Code #
1. Public Land Survey	T 42N R 15W T 41N R 15W T _____ R _____ T _____ R _____	E-13 E-1 ✓
2. Property Controlling in Section	S _____ T _____ R _____ S _____ T _____ R _____	
3. Miscellaneous Property in Sec.	S _____ T _____ R _____ S _____ T _____ R _____	

Received & Filed this 6th day of
Dec. 1995 at 11:39 A M
Sigrid I. Hedberg
Schoolcraft Co. Reg. of Deeds

Register of Deeds Stamp & File Number

4. Lot No. _____, Recorded Plat _____
5. Private Claims _____

A	B	C	D	E	F	G	H	I	J	K	L	M
2	6	5	4	3	2	1						
3												
4	7	8	9	10	11	12						
5												
6	16	17	16	15	14	13						
7												
8	19	20	21	22	23	24						
9												
10	30	29	28	27	26	25						
11												
12	31	32	33	34	35	36						
13												

I, Thomas P. O'Brien in a field survey on Oct. 6, 1995, do hereby certify that under requirements of P.A. 74, Michigan P.A. of 1970, the corner points mentioned in lines 1 and 2 above were in conformance with regulations and rules therefore as required in the current manual of survey instructions of the United States Department of the Interior, Bureau of Land Management or by a decree of a Court of Law and/or that the corner points mentioned in lines 3, 4 and 5 above were in conformance with the rules of the Michigan Board of Land Surveyors or by a Decree of a Court of Law, established, re-established, monumented, re-monumented, recovered, found as expressed below:

NOTE: Not more than 4 corners, all in the same town and range, may be recorded on this certificate.

A. Description of original monument and accessories and/or subsequent restoration:


E-13 (S.E. Corner Sec. 32)
Aug. 6, 1845 John Burt D.S. set corner post.
Maple 6 N24W 11 Beech 4 N40E 27
Sept. 9/45 John Burt D.S. South between sections 4&5.
Beech 10 S43E 22 do 5 S32W 24

B. Description of corner evidence found and/or method applied in restoring or reestablishing corner:

E-13 Aug. 5, 1976 Thomas P. O'Brien, RLS "found iron pipe in E & W road @ intersection of road to the North.
E-13 Oct. 6, 1994 Thomas P. O'Brien, PS recovered a 1" solid iron rod .60' below road surface at intersection. Corner was previously stated to be an iron pipe. Bearing trees verify corner to be at same position as on Aug. 5, 1976.

C. Description of monument for corner and accessories established to perpetuate locating the position of the corner:

E-13 1" solid iron rod set in monument box.
Witnesses:
Power Pole N84°E 186.15'
Power Pole S40°E 80.85'
Power Pole S49°W 44.55'
Power Pole N45°W 45.30'

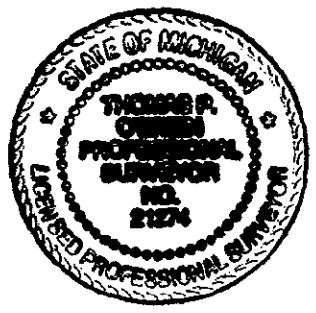

Thomas P. O'Brien

Signed by Thomas P. O'Brien, PS Date Dec. 4, 1995

Surveyor's Michigan License No. 21274