

**SCHOOLCRAFT COUNTY  
PEER GROUP APPROVED**

RECORDED

JAN 25 2000

DATE 11/8/99 JOB LAND CORNER RECORDATION CERTIFICATE  
Filing Requirement of Act 74, Mich. P.A. 1970

SECTION

For corners in

Schoolcraft  
(County)

Located In:

Corner Code #

SIGRID HEDBERG 1P  
SCHOOLCRAFT CO. REGISTER  
Page 1 of 1 LC 4/309  
JLO Date 12/22/1999 Time 13:55:34  
RECORDING FEES: 9.00

1. Public Land Survey	T	<u>41NR</u>	<u>15W</u>	F3
	T	_____	_____	_____
	T	_____	_____	_____
	T	_____	_____	_____
2. Property Controlling in Section	S	_____	_____	_____
	S	_____	_____	_____
3. Miscellaneous Property in Sec.	S	_____	_____	_____
	S	_____	_____	_____

Register of Deeds Stamp & File Number

4. Lot No. \_\_\_\_\_, Recorded Plat \_\_\_\_\_  
5. Private Claims \_\_\_\_\_

I, Thomas P. O'Brien, in a field survey on 12/13, 1999 do hereby state that under requirements of P.A. 74, Michigan P.A. of 1970, the corner points mentioned in lines 1 and 2 above were in conformance with regulations and rules therefore as required in the current manual of survey instructions of the United States Department of the Interior, Bureau of Land Management or by a decree of a Court of Law and/or that the corner points mentioned in lines 3, 4 and 5 above were in conformance with the rules of the Michigan Board of Land Surveyors or by a Decree of a Court of Law; established, re-established, monumented, recovered, found as expressed below:

NOTE: Not more than 2 corners, all in the same town and range, may be recorded on this certificate.

A	B	C	D	E	F	G	H	I	J	K	L	M
1												
2	6	5			4		3		2		1	
3												
4	7	8			9		10		11		12	
5												
6	18	17			16		15		14		13	
7												
8	19	20			21		22		23		24	
9												
10	30	29			28		27		26		25	
11												
12	31	32			33		34		35		36	
13												

A. Description of original monument and accessories and/or subsequent restoration:


Sept. 8, 1845 J. Burt, DS set qr. sec. post Fir 6 S56E 47 Maple 6 N68E 48  
Nov. 28, 1899 A.C. Carpenter, County Surveyor notes 5/8" iron bar in road center in Liber 1 Record of Surveys Page 10.  
March 8, 1977 Thomas P. O'Brien, PS notes corner referenced to in Plat of Lakeview Bluff.  
May 11, 1978 Douglas W. Hooth, RLS found P.K. Nail by chainage from section corner east. Found Polaris Assc. Inc. reference marker RLS 14200 in 13" W. Pine S18°W 78.00'. Added additional witnesses and filed LCRG.

B. Description of corner evidence found and/or method applied in restoring or reestablishing corner:

Dec. 13, 1999 Thomas P. O'Brien, PS restored corner from 1978 Hooth witnesses. Corner falls in centerline of highway US-2. Traffic conditions too hazardous to occupy corner or monument with monument box. Set witnesses iron bars w/O'BRIEN 21274 caps at right angles to section line to East 100.0' North and 100.0' South.

C. Description of monument for corner and accessories established to perpetuate locating the position of the corner:

P.K. Nail in centerline US-2  
Witnesses:  
12" Twin Maple North 62.58'  
13" W. Pine N40°W 76.30'  
7" Maple N43°E 81.90'  
13" W. Pine S18°W 78.00'  
Iron Bars referenced to in "B".  
Carsonite Post South 50.0'

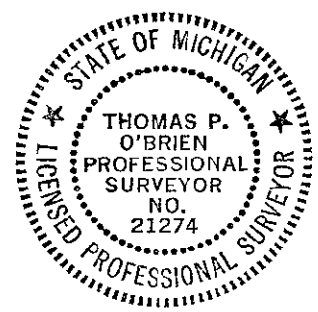

Signed by Thomas P. O'Brien  
Surveyor's Michigan License No. 21274

Date 12/16/99