

**SCHOOLCRAFT COUNTY
PEER GROUP APPROVED**

JAN 25 2000

DATE 11/8/99 DOB LAND CORNER RECORDATION CERTIFICATE
Filing Requirement of Act 74, Mich. P.A. 1970

SECTION

For corners in

Schoolcraft
(County)

Located In:

Corner Code #

SIGRID HEDBERG
SCHOOLCRAFT CO. REGISTER 1P
Page 1 of 1
JLV Date 12/22/1999 LC 4/303
RECORDING FEES: Time 13:53:59
9.00

1. Public Land Survey

T41NR 15W G2

2. Property Controlling in Section

S T R

3. Miscellaneous Property in Sec.

S T R

4. Lot No. _____, Recorded Plat _____

5. Private Claims _____

Register of Deeds Stamp & File Number

	A	B	C	D	E	F	G	H	I	J	K	L	M
1													
2	6		5		4	X	3		2				
3													
4	7		8		9		10		11				
5													
6	18		17		16		15		14				
7													
8	19		20		21		22		23				
9													
10	30		29		28		27		26				
11													
12	31		32		33		34		35				
13													

I, Thomas P. O'Brien in a field survey on 11/22, 1999 do hereby state that under requirements of P.A. 74, Michigan P.A. of 1970, the corner points mentioned in lines 1 and 2 above were in conformance with regulations and rules therefore as required in the current manual of survey instructions of the United States Department of the Interior, Bureau of Land Management or by a decree of a Court of Law and for that the corner points mentioned in lines 3, 4 and 5 above were in conformance with the rules of the Michigan Board of Land Surveyors or by a Decree of a Court of Law; established, re-established, monumented, recovered, found as expressed below:


NOTE: Not more than 2 corners, all in the same town and range, may be recorded on this certificate.

A. Description of original monument and accessories and/or subsequent restoration:
Sept. 8, 1845 J. Burt, DS set qr. sec. post Beech 10 N8E 35 Maple 8 S16W 18
June 20, 1913 Ernest Weaver, County Surveyor notes "8" Cedar Post" in Liber 1 of Record of Surveys, Page 76.
May 11, 1978 Douglas W. Hooth RLS found 3/4" O.D. iron pipe by chaining distance shown on 1939 State Hwy. Dept. plans. Set 1/2" copper clad pin w/RLS cap 16944 inside 3/4" pipe.
Oct. 5, 1994 Gary E. Koepke, PS found 3/4" pipe w/1/2" pin w/RLS 16944 cap set in pipe.

B. Description of corner evidence found and/or method applied in restoring or reestablishing corner:
Nov. 22, 1999 Thomas P. O'Brien, PS found 1/2" copper clad pin w/16944 cap set in rotted post remains. Reset w/Schoolcraft County monument stamped to identify.

C. Description of monument for corner and accessories established to perpetuate locating the position of the corner:

- Schoolcraft County monument.
Witnesses:
4" White Pine N29°E 52.90'
6" White Pine S50°E 40.42'
6" White Pine S75°W 66.80'
4" White Pine N54°W 90.30'
Carsonite Post North 1.0'

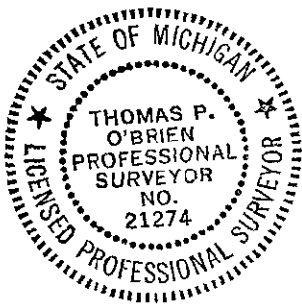

Signed by Thomas P. O'Brien
Surveyor's Michigan License No. 21274

Date Dec. 16, 1999