

SCHOOLCRAFT COUNTY PEER GROUP APPROVED

JAN 25 2000

DATE 11/8/99 JOB LAND CORNER RECORDATION CERTIFICATE SECTION

For corners in

Schoolcraft

(County)

Located In:

Corner Code #

STANLEY HEBBERG

SCHOOLCRAFT CO. REGISTER

1P

Page 1 of 1

LC 4/311

JLV Date 12/22/1999

Time 13:56:00

RECORDING FEES:

9.00

1. Public Land Survey	T <u>41</u> N R <u>15</u> W	<u>J3</u>
	T <u> </u> R <u> </u>	<u> </u>
	T <u> </u> R <u> </u>	<u> </u>
	T <u> </u> R <u> </u>	<u> </u>
2. Property Controlling in Section	S <u> </u> T <u> </u> R <u> </u>	<u> </u>
	S <u> </u> T <u> </u> R <u> </u>	<u> </u>
3. Miscellaneous Property in Sec.	S <u> </u> T <u> </u> R <u> </u>	<u> </u>
	S <u> </u> T <u> </u> R <u> </u>	<u> </u>

Register of Deeds Stamp & File Number

4. Lot No. _____, Recorded Plat _____
5. Private Claims _____

I, Thomas P. O'Brien, in a field survey on 11/22, 1999 do hereby state that under requirements of P.A. 74, Michigan P.A. of 1970, the corner points mentioned in lines 1 and 2 above were in conformance with regulations and rules therefore as required in the current manual of survey instructions of the United States Department of the Interior, Bureau of Land Management or by a decree of a Court of Law and/or that the corner points mentioned in lines 3, 4 and 5 above were in conformance with the rules of the Michigan Board of Land Surveyors or by a Decree of a Court of Law; established, re-established, monumented, recovered, found as expressed below:

NOTE: Not more than 2 corners, all in the same town and range, may be recorded on this certificate.

	A	B	C	D	E	F	G	H	I	J	K	L	M
1													
2	6		5		4		3		2		1		
3										X			
4	7		8		9		10		11		12		
5													
6	18		17		16		15		14		13		
7													
8	19		20		21		22		23		24		
9													
10	30		29		28		27		26		25		
11													
12	31		32		33		34		35		36		
13													

A. Description of original monument and accessories and/or subsequent restoration:


Sept. 7, 1845 John Burt, DS set qr. section post Fir 5 S74E 16 Cedar 9 N74W 6
Nov. 27, 1991 Thomas P. O'Brien, PS recovered iron bar in centerline of county road and in line to old fence line to North.

B. Description of corner evidence found and/or method applied in restoring or reestablishing corner:

Nov. 22, 1999 Thomas P. O'Brien, PS recovered iron bar (boat spike) used in previous surveys. Replaced boat spike with iron bar w/OBRIEN 21274 cap set in monument box.

C. Description of monument for corner and accessories established to perpetuate locating the position of the corner:

- Iron bar w/OBRIEN 21274 cap
- Witnesses:
- 6" Cedar S50°E 97.50'
- Power Pole S3°W 32.03'
- Power Pole N1°W 49.43'
- 911 Sign N60°E 66.35'
- Carsonite Post North 45.0'

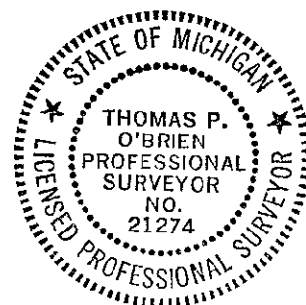

Thomas P. O'Brien

Signed by Thomas P. O'Brien

Date 12/16/99

Surveyor's Michigan License No. 21274