

**SCHOOLCRAFT COUNTY
PEER GROUP APPROVED**

DATE 7/12/96 ^{TOB} **LAND CORNER RECORDATION CERTIFICATE**
Filing Requirement of Act 74, Mich. P.A. 1970

SURVEY &
REMONUMENTATION
OCT 2 1996
COMMISSION

For corners in

<u>Schoolcraft</u> <small>(County)</small>	Located In:	Corner Code --#
1. Public Land Survey	T <u>42 N</u> R <u>15 W</u>	<u>K-13</u>
	T <u>41 N</u> R <u>15 W</u>	<u>K-1</u> ✓
	T _____ R _____	_____
	T _____ R _____	_____
2. Property Controlling in Section	S _____ T _____ R _____	_____
	S _____ T _____ R _____	_____
3. Miscellaneous Property in Sec.	S _____ T _____ R _____	_____
	S _____ T _____ R _____	_____

Received & Filed this 8th day of
October 19 96 at 11:35 A M
Sigrid I. Hedberg
Schoolcraft Co. Reg. of Deeds

Register of Deeds Stamp & File Number

4. Lot No. _____, Recorded Plat _____
5. Private Claims _____

	A	B	C	D	E	F	G	H	I	J	K	L	M
2	6	5	4	3	2	1							
3													
4	7	8	9	10	11	12							
5													
6	18	17	16	15	14	13							
7													
8	19	20	21	22	23	24							
9													
10	30	29	28	27	26	25							
11													
12	31	32	33	34	35	36							
13													

Thomas P. O'Brien in a field survey on August 13, 19 96
do hereby certify that under requirements of P.A. 74, Michigan P.A. of 1970, the corner points mentioned
in lines 1 and 2 above were in conformance with regulations and rules therefore as required in the
current manual of survey instructions of the United States Department of the Interior, Bureau of Land
Management or by a decree of a Court of Law and/or that the corner points mentioned in lines 3, 4 and 5
above were in conformance with the rules of the Michigan Board of Land Surveyors or by a Decree of a
Court of Law; established, re-established, monumented, re-monumented, recovered, found as
expressed below:

**NOTE: Not more than 4 corners, all in the same town and range, may be recorded
on this certificate.**

A. Description of original monument and accessories and/or subsequent restoration:

K-13 (S.E. Corner Sec. 35)
Aug. 6, 1845 John Burt set corner post.
Sugar 10 N61W 10 Beech 10 N55 E 9

Sept. 7/45 John Burt D.S. South between sections 1&2
Sugar 6 S49E 21 do 4 S40W 29

SURVEY &
REMONUMENTATION
OCT 16 1996
COMMISSION


B. Description of corner evidence found and/or method applied in restoring or reestablishing corner:

K-13 August 13, 1996 Thomas P. O'Brien P.S. Recovered a 2" Iron pin as noted
in M.S.H.D. 1936 Highway plans for U.S. - 2. Distance South to R/W
monuments as noted in plans checks well. Reset Iron pin with Schoolcraft
County Monument.

C. Description of monument for corner and accessories established to perpetuate locating the position of the corner:

K-13 Set Schoolcraft County Monument stamped to identify.

- Witnesses:
- 6" Maple - S28°E - 14.10'
 - 8" Maple - S 9°W - 55.82'
 - 6" beech - S44°W - 28.12'
 - 4" Beech - N88°E - 6.35'
 - 4' Cedar post - N4°E - 3.0'

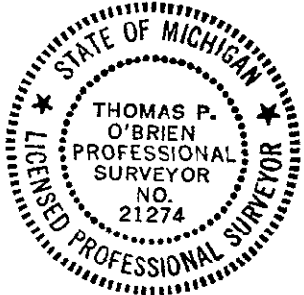

Signed by Thomas P. O'Brien Date August 13, 1996

Surveyor's Michigan License No. 21274