

**SCHOOLCRAFT COUNTY
PEER GROUP APPROVED**

RECORDED

JAN 25 2000

SECTION

DATE 11/8/99 JOB LAND CORNER RECORDATION CERTIFICATE
Filing Requirement of Act 74, Mich. P.A. 1970

For corners in

<u>Schoolcraft</u> (County)	Located In:	Corner Code #
1. Public Land Survey	T <u>41N</u> R <u>15W</u>	<u>K3</u>
	T___ R___	_____
	T___ R___	_____
	T___ R___	_____
2. Property Controlling in Section	S___ T___ R___	_____
	S___ T___ R___	_____
3. Miscellaneous Property in Sec.	S___ T___ R___	_____
	S___ T___ R___	_____

SIGRID HEDBERG
SCHOOLCRAFT CO. REGISTER 1P
Page 1 of 1 LC 4/293
JLV Date 12/22/1999 Time 13:50:11
RECORDING FEES: 9.00

Register of Deeds Stamp & File Number

4. Lot No. _____, Recorded Plat _____
5. Private Claims _____

I, Thomas P. O'Brien, in a field survey on 12/14/99, 19__ do hereby state that under requirements of P.A. 74, Michigan P.A. of 1970, the corner points mentioned in lines 1 and 2 above were in conformance with regulations and rules therefore as required in the current manual of survey instructions of the United States Department of the Interior, Bureau of Land Management or by a decree of a Court of Law and/or that the corner points mentioned in lines 3, 4 and 5 above were in conformance with the rules of the Michigan Board of Land Surveyors or by a Decree of a Court of Law; established, re-established, monumented, recovered, found as expressed below:

NOTE: Not more than 2 corners, all in the same town and range, may be recorded on this certificate.

	A	B	C	D	E	F	G	H	I	J	K	L	M
1													
2		6		5		4		3		2		1	
3											*		
4		7		8		9		10		11		12	
5													
6		18		17		16		15		14		13	
7													
8		19		20		21		22		23		24	
9													
10		30		29		28		27		26		25	
11													
12		31		32		33		34		35		36	
13													

A. Description of original monument and accessories and/or subsequent restoration:

Sept.7, 1845 J. Burt, DS set post corner of Sections 1,2,11,12
Cedar 10 N70W 12 Do 10 S44E 10


B. Description of corner evidence found and/or method applied in restoring or reestablishing corner:

July 31, 1987 Ferguson & Chamberlain Associates, Inc. reestablished corner by proportionate measurement.

Dec.14, 1999 Thomas P. O'Brien, PS replaced Ferguson & Chamberlain iron bar with Schoolcraft County monument stamped to identify.

C. Description of monument for corner and accessories established to perpetuate locating the position of the corner:

Schoolcraft County monument
Witnesses:
6" Cedar S27°E 11.75'
10" Cedar S55°W 9.30'
6" Spruce N25°W 12.85'
4" Cedar N50°E 26.65'
Carsonite Post North 1.0'

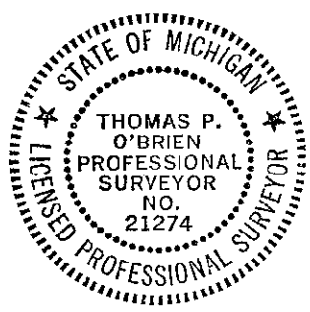

Signed by Thomas P. O'Brien
Surveyor's Michigan License No. 21274

Date 12/16/99