

FEB 08 2001

SCHOOLCRAFT COUNTY PEER GROUP APPROVED

SECTION

DATE 10/10/00 JOR LAND CORNER RECORDATION CERTIFICATE Filing Requirement of Act 74, Mich. P.A. 1970

For corners in

Schoolcraft

(County)

Located In:

Corner Code #

1. Public Land Survey

T 42N R 13W

A6

T R

T R

T R

T R

2. Property Controlling in Section

S

T R

S

T R

3. Miscellaneous Property in Sec.

S

T R

S

T R

SIGRID HEDBERG 1P SCHOOLCRAFT CO. REGISTER Page 1 of 1 LC 4/426 JLV Date 12/28/2000 Time 11:28:17

Register of Deeds Stamp & File Number

4. Lot No. , Recorded Plat 5. Private Claims

I, Thomas P. O'Brien, in a field survey on 19 do hereby state that under requirements of P.A. 74, Michigan P.A. of 1970, the corner points mentioned in lines 1 and 2 above were in conformance with regulations and rules therefore as required in the current manual of survey instructions of the United States Department of the Interior, Bureau of Land Management or by a decree of a Court of Law and/or that the corner points mentioned in lines 3, 4 and 5 above were in conformance with the rules of the Michigan Board of Land Surveyors or by a Decree of a Court of Law; established, re-established, monumented, recovered, found as expressed below:

NOTE: Not more than 2 corners, all in the same town and range, may be recorded on this certificate.

Grid table with columns A-L and rows 1-13. Contains numbers 1-36 in a grid pattern.

A. Description of original monument and accessories and/or subsequent restoration:

April 1851 Algernon Merryweather, DS destroyed Guy H. Carleton post and witnesses in remeasurement.

March 1984 William F. Bowman, ILS "set by proportionate measure on line between A5 and A7."

B. Description of corner evidence found and/or method applied in restoring or reestablishing corner:

Nov.10, 2000 Thomas P.O'Brien, PS found 5/8" iron bar with 3" Mead cap and ILS 28406 stamp as set by Bowman.

C. Description of monument for corner and accessories established to perpetuate locating the position of the corner:

5/8" ironbar with 3" Mead cap stamped to identify.

Witnesses:

10" Cedar N21°E 7.8'

6" Balsam N33°W 7.65'

6" Balsam West 6.25'

8" Cedar S35°W 20.80'


Carsonite Post North 1.0'

Signature of Thomas P. O'Brien

Signed by Thomas P. O'Brien

Surveyor's Michigan License No. 21274

Date Dec.19, 2000

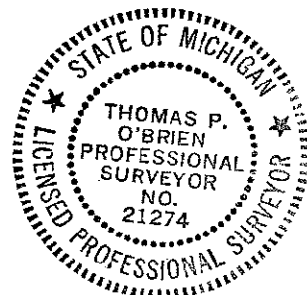

LIBER 4 PAGE: 426