

SCHOOLCRAFT COUNTY
PEER GROUP APPROVED

DATE 9/13/96

LAND CORNER RECORDATION CERTIFICATE
 Filing Requirement of Act 74, Mich. P.A. 1970

SURVEY &
 REMONUMENTATION

NOV 21 1996

COMMISSION

For corners in

<u>Schoolcraft</u> (County)	Located In:	Corner Code #
1. Public Land Survey	T <u>42 N</u> R <u>15 W</u>	<u>M-3</u>
	T <u>42 N</u> R <u>14 W</u>	<u>A-3</u>
	T _____ R _____	_____
	T _____ R _____	_____
2. Property Controlling in Section	S _____ T _____ R _____	_____
	S _____ T _____ R _____	_____
3. Miscellaneous Property in Sec.	S _____ T _____ R _____	_____
	S _____ T _____ R _____	_____
4. Lot No. _____, Recorded Plat _____		
5. Private Claims _____		

Received & Filed this 30 day of
Oct 1996 at 11:35 AM
 Sigrid I. Hedberg
 Schoolcraft Co. Reg. of Deeds

Register of Deeds Stamp & File Number

	A	B	C	D	E	F	G	H	I	J	K	L	M
2	6	5	4	3	2	1							
3													X
4	7	8	9	10	11	12							
5													
6	18	17	16	15	14	13							
7													
8	19	20	21	22	23	24							
9													
10	30	29	28	27	26	25							
11													
12	31	32	33	34	35	36							
13													

I, Thomas P. O'Brien, in a field survey on April 2, 1996, do hereby certify that under requirements of P.A. 74, Michigan P.A. of 1970, the corner points mentioned in lines 1 and 2 above were in conformance with regulations and rules therefore as required in the current manual of survey instructions of the United States Department of the Interior, Bureau of Land Management or by a decree of a Court of Law and/or that the corner points mentioned in lines 3, 4 and 5 above were in conformance with the rules of the Michigan Board of Land Surveyors or by a Decree of a Court of Law, established, re-established, monumented, re-monumented, recovered, found as expressed below:

NOTE: Not more than 4 corners, all in the same town and range, may be recorded on this certificate.

A. Description of original monument and accessories and/or subsequent restoration:

M-3 (S.E. Corner Sec. 1)
 Sept. 11/50 Algernon Merryweather D.S. set corner post.
 N. Pine 18 in N70W 24 links N. Pine 16" S75W 43 "

SURVEY &
 REMONUMENTATION

DEC 16 1996

COMMISSION

B. Description of corner evidence found and/or method applied in restoring or reestablishing corner:


M-3 May 10, 1961- Billy D. Buckler, RLS set a 1" pipe with 4" brass cap" from the remains of two N. Pine B.T.'s bearing N 70 deg. W. 24 lks. and S 75 deg. W. 43 links, both stumps badly burned. Found notch on SW stump."

April 2, 1996 - Thomas P. O'Brien P.S. recovered a 1" pipe with cap missing, as set by Billy D. Buckler on May 10, 1961.

C. Description of monument for corner and accessories established to perpetuate locating the position of the corner:

M-3 Reset 1" pipe found with a Schoolcraft County Monument stamped to identify.

Witnesses: Fd. 12" Jack Pine- N40°W - 11.15' Ex. Cond.
 Fd. 6" Jack Pine- N38°E - 14.60' " "
 Fd. 8" Jack Pine- S37°E - 30.55" " "
 Fd. 8" Jack Pine- S 9°W - 25.30' " "
 . 4" Cedar Post- North - 2.0'

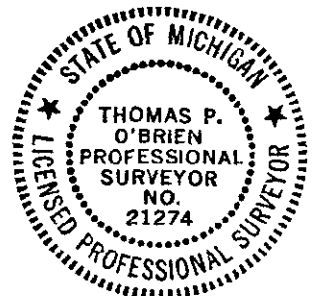

Signed by Thomas P. O'Brien Date April 2, 1996

Surveyor's Michigan License No. 21274