

SCHOOLCRAFT COUNTY
PEER GROUP APPROVED

DATE 9/13/96

LAND CORNER RECORDATION CERTIFICATE
 Filing Requirement of Act 74, Mich. P.A. 1970

SURVEY &
 REMONUMENTATION

NOV 2 1996

COMMISSION

For corners in

<u>Schoolcraft</u> <small>(County)</small>	Located In:	Corner Code #
1. Public Land Survey	T 42 N R 15 W T 42 N R 14 W T _____ R _____ T _____ R _____	M-4 A-4 ✓
2. Property Controlling in Section	S _____ T _____ R _____ S _____ T _____ R _____	
3. Miscellaneous Property in Sec.	S _____ T _____ R _____ S _____ T _____ R _____	

Received & Filed this 30 day of
Oct 19 96 at 11:36 A M
 Sigrid I. Hedberg
 Schoolcraft Co. Reg. of Deeds

Register of Deeds Stamp & File Number

4. Lot No. _____, Recorded Plat _____
 5. Private Claims _____

A	B	C	D	E	F	G	H	I	J	K	L	M
2	6	5	4	3	2	1						
3												
4	7	8	9	10	11	12	X					
5												
6	18	17	16	15	14	13						
7												
8	19	20	21	22	23	24						
9												
10	30	29	28	27	26	25						
11												
12	31	32	33	34	35	36						
13												

I, Thomas P. O'Brien, in a field survey on April 3, 19 96, do hereby certify that under requirements of P.A. 74, Michigan P.A. of 1970, the corner points mentioned in lines 1 and 2 above were in conformance with regulations and rules therefore as required in the current manual of survey instructions of the United States Department of the Interior, Bureau of Land Management or by a decree of a Court of Law and/or that the corner points mentioned in lines 3, 4 and 5 above were in conformance with the rules of the Michigan Board of Land Surveyors or by a Decree of a Court of Law; established, re-established, monumented, re-monumented, recovered, found as expressed below:

NOTE: Not more than 4 corners, all in the same town and range, may be recorded on this certificate.

A. Description of original monument and accessories and/or subsequent restoration:

M-4 (East 1/4 Corner Sec. 12)
 Ash 6 in. S80W 9 links Birch 6" N30W 32 "

SURVEY &
 REMONUMENTATION

DEC 16 1996

COMMISSION

B. Description of corner evidence found and/or method applied in restoring or reestablishing corner:


M-4 Nov. 5, 1969- Frank J. Bray, RLS set a 1" pipe with 4" Aluminum cap.
 "Midway and on line between section corners to the North and to the South."

April 3, 1996- Thomas P. O'Brien P.S. recovered a 1" pipe with 4" Aluminum cap as set by Frank J. Bray on Nov. 5, 1969.

C. Description of monument for corner and accessories established to perpetuate locating the position of the corner:

M-4 Found a Dept. of Cons. 1" pipe with 4" Aluminum cap stamped to identify.

Witnesses: Fd. 12" Red Pine- N62°E - 44 lks. Good Cond.
 Fd. 8" Red Pine- S37°E - 56½lks. " "
 10" Red Pine- S 1°W - 65.20' NBT
 12" Red Pine- S60°W - 20.10' NBT
 4" Cedar Post - North 1.5'

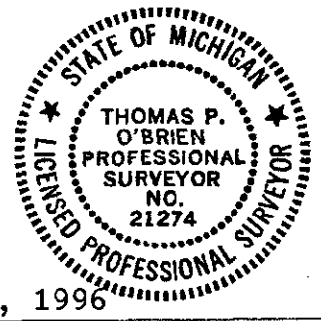

Signed by Thomas P. O'Brien

Date April 3, 1996

Surveyor's Michigan License No. 21274

LIBER 4 PAGE: 62