

**SCHOOLCRAFT COUNTY
PEER GROUP APPROVED**

21 47 71

JAN 30 1996

DATE Dec. 7, 1995

LAND CORNER RECORDATION CERTIFICATE
Filing Requirement of Act 74, Mich. P.A. 1970

COMMISSION

For corners in

Schoolcraft (County) Located in: Corner Code #

1. Public Land Survey T 42 N R 15 W M-8
T 42 N R 14 W A-8 ✓
T _____ R _____
T _____ R _____

2. Property Controlling S _____ T _____ R _____
in Section S _____ T _____ R _____

3. Miscellaneous S _____ T _____ R _____
Property in Sec. S _____ T _____ R _____

Received & Filed this 26 day of
Dec 1995 at 2:38 PM
Sigrid I. Hedberg
Schoolcraft Co. Reg. of Deeds

Register of Deeds Stamp & File Number

4. Lot No. _____, Recorded Plat _____
5. Private Claims _____

	A	B	C	D	E	F	G	H	I	J	K	L	M
2	6	5	4	3	2	1							
3													
4	7	8	9	10	11	12							
6													
6	18	17	16	15	14	13							
7													
8	19	20	21	22	23	24							
9													
10	30	29	28	27	26	25							
11													
12	31	32	33	34	35	36							
13													

I, Thomas P. O'Brien, in a field survey on Dec. 27, 19 93, do hereby certify that under requirements of P.A. 74, Michigan P.A. of 1970, the corner points mentioned in lines 1 and 2 above were in conformance with regulations and rules therefore as required in the current manual of survey instructions of the United States Department of the Interior, Bureau of Land Management or by a decree of a Court of Law and/or that the corner points mentioned in lines 3, 4 and 5 above were in conformance with the rules of the Michigan Board of Land Surveyors or by a Decree of a Court of Law; established, re-established, monumented, re-monumented, recovered, found as expressed below:

NOTE: Not more than 4 corners, all in the same town and range, may be recorded on this certificate.

A. Description of original monument and accessories and/or subsequent restoration:


M-8 (East 1/4 Corner Sec. 24)
Sept 10, 1850 Algernon Merryweather D.S. 1/4 post
Sugar 12 in. N20 W 22 links do 14 " S50W 31 "

B. Description of corner evidence found and/or method applied in restoring or reestablishing corner:

M-8 Dec. 27, 1993 Thomas P. O'Brien, PS recovered 1/2" iron bar with plastic PS cap # 28406. Testimony of William F. Bowman and measured distances verify corner was set by single proportionment distance between M7 and M12. Replace 28406 iron bar with Schoolcraft County monument.

C. Description of monument for corner and accessories established to perpetuate locating the position of the corner:

M-8 Schoolcraft County monument stamped to identify.
Witnesses:
8" Maple N57°E 47.20 (existing witness in poor condition)
10" maple S26°E 25.0' (existing witness in good condition)
Power Pole S25°W 131.48'
8" Maple N50°W 86.60'
Center of concrete project marker N3°E 114.85'
Cedar post East 1.5'
Centerline county road West 21.0'

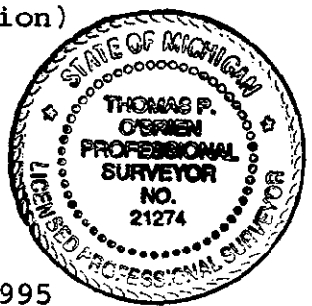

Signed by Thomas P. O'Brien Date Dec. 20, 1995

Surveyor's Michigan License No. 21274

LIBER 4 PAGE: 2/6