

SURVEY & REMONUMENTATION

FEB 08 2001

SCHOOLCRAFT COUNTY  
PEER GROUP APPROVED

LAND CORNER RECORDATION CERTIFICATE  
Filing Requirement of Act 74, Mich. P.A. 1970

SECTION

DATE 10/10/00 JPB  
For corners in

Schoolcraft (County)	Located In:	Corner Code #
1. Public Land Survey	T <u>42N</u> R <u>14W</u>	<u>K9</u>
	T ___ R ___	_____
	T ___ R ___	_____
	T ___ R ___	_____
2. Property Controlling in Section	S ___ T ___ R ___	_____
	S ___ T ___ R ___	_____
3. Miscellaneous Property in Sec.	S ___ T ___ R ___	_____
	S ___ T ___ R ___	_____

SIGRID HEDBERG 1P  
SCHOOLCRAFT CO. REGISTER  
Page 1 of 1 LC 4/405  
JLV Date 12/19/2000 Time 11:53:40

Register of Deeds Stamp & File Number

4. Lot No. \_\_\_\_\_, Recorded Plat \_\_\_\_\_  
5. Private Claims \_\_\_\_\_

I, Thomas P. O'Brien, in a field survey on 10/17/00 do hereby state that under requirements of P.A. 74, Michigan P.A. of 1970, the corner points mentioned in lines 1 and 2 above were in conformance with regulations and rules therefore as required in the current manual of survey instructions of the United States Department of the Interior, Bureau of Land Management or by a decree of a Court of Law and/or that the corner points mentioned in lines 3, 4 and 5 above were in conformance with the rules of the Michigan Board of Land Surveyors or by a Decree of a Court of Law; established, re-established, monumented, recovered, found as expressed below:

NOTE: Not more than 2 corners, all in the same town and range, may be recorded on this certificate.

	A	B	C	D	E	F	G	H	I	J	K	L	M
1													
2	6		5		4		3		2		1		
3													
4	7		8		9		10		11		12		
5													
6	18		17		16		15		14		13		
7													
8	19		20		21		22		23		24		
9													
10	30		29		28		27		26		25		
11													
12	31		32		33		34		35		36		
13													

A. Description of original monument and accessories and/or subsequent restoration:

April 4, 1851 Algernon Merryweather, DS set section corner Sections 23,24,25,26 Tamarack 8 in S15W 10 links WPine 18 in N41E 61 links


March 1984 William F. Bowman, LLS "found railroad spike below road surface, position checks well with dimensions from M.S.H.D. plans for project 77-1001 of 1937."

B. Description of corner evidence found and/or method applied in restoring or reestablishing corner:

Oct. 17, 2000 Thomas P. O'Brien, PS found P.K. from 1998-99 corner preservation resurface project. Reset with 1/2" iron bar with OBRIEN 21274 cap in monument box.

C. Description of monument for corner and accessories established to perpetuate locating the position of the corner:

- 1/2" iron bar with OBRIEN 21274 cap in monument box.
- Witnesses:
- Power Pole S18°E 83.20'
- County road sign post N59°W 39.65'
- Top of angle iron at S end of culvert S76°W 35.35'
- CENTERline West .5'
- Carsonite Post S85°E 40.0'

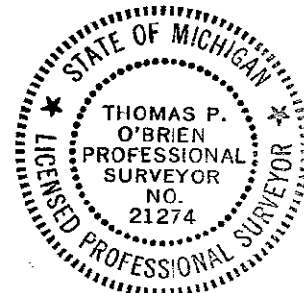

Signed by Thomas P. O'Brien  
Surveyor's Michigan License No. 21274

Date DEC. 18, 2000