

SCHOOLCRAFT COUNTY
PEER GROUP APPROVED

SURVEY &
REMONUMENTATION

DATE 10/10/00 JOB

FEB 08 2001

LAND CORNER RECORDATION CERTIFICATE
Filing Requirement of Act 74, Mich. P.A. 1970

SECTION

For corners in

Schoolcraft (County)	Located in:	Corner Code #
1. Public Land Survey	T42N R14W	L5
	T R	
	T R	
	T R	
2. Property Controlling in Section	S T R	
	S T R	
3. Miscellaneous Property in Sec.	S T R	
	S T R	

SIGRID HEDBERG 1P
SCHOOLCRAFT CO. REGISTER
Page 1 of 1 LC 4/401
JLV Date 12/19/2000 Time 11:53:37

Register of Deeds Stamp & File Number

4. Lot No. _____, Recorded Plat _____
5. Private Claims _____

	A	B	C	D	E	F	G	H	I	J	K	L	M
1													
2	6		5		4		3		2		1		
3													
4	7		8		9		10		11		12		
5													
6	18		17		16		15		14		13		
7													
8	19		20		21		22		23		24		
9													
10	30		29		28		27		26		25		
11													
12	31		32		33		34		35		36		
13													

I, Thomas P. O'Brien, in a field survey on 11/7/00, do hereby state that under requirements of P.A. 74, Michigan P.A. of 1970, the corner points mentioned in lines 1 and 2 above were in conformance with regulations and rules therefore as required in the current manual of survey instructions of the United States Department of the Interior, Bureau of Land Management or by a decree of a Court of Law and /or that the corner points mentioned in lines 3, 4 and 5 above were in conformance with the rules of the Michigan Board of Land Surveyors or by a Decree of a Court of Law, established, re-established, monumented, recovered, found as expressed below:

NOTE: Not more than 2 corners, all in the same town and range, may be recorded on this certificate.

A. Description of original monument and accessories and/or subsequent restoration:

April 5, 1851 Algernon Merryweather, DS set 1/4 post Sugar 16 in N15W 12 links Balsam 6 in S20E 36 links.

B. Description of corner evidence found and/or method applied in restoring or reestablishing corner:


Nov. 7, 2000 Thomas P. O'Brien, PS set corner by single proportionate measurement between K5 and M5.

C. Description of monument for corner and accessories established to perpetuate locating the position of the corner:

Schoolcraft County monument stamped to identify.

Witnesses:

- 10" Ironwood S28°W 32.72'
- 8" Maple S11°E 35.63'
- 10" Maple N56°E 20.65'
- 8" Maple N64°W 29.63'
- Carsonite Post North 1.0'

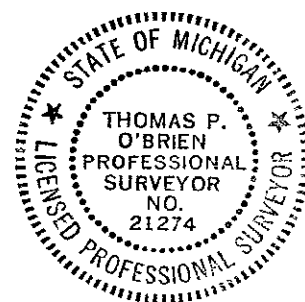

Thomas P. O'Brien

Signed by Thomas P. O'Brien
Surveyor's Michigan License No. 21274

Date Dec 11, 2000