

FEB 08 2001

SCHOOLCRAFT COUNTY PEER GROUP APPROVED

DATE 10/10/00 JPB LAND CORNER RECORDATION CERTIFICATE Filing Requirement of Act 74, Mich. P.A. 1970

SECTION

For corners in

Table with columns: Schoolcraft (County), Located In, Corner Code #. Includes entries for Public Land Survey, Property Controlling in Section, and Miscellaneous Property in Sec.

SIGRID HEDBERG 1P SCHOOLCRAFT CO. REGISTER Page 1 of 1 LC 4/412 JLV Date 12/28/2000 Time 11:28:08

Register of Deeds Stamp & File Number

4. Lot No. , Recorded Plat 5. Private Claims

I, Thomas P. O'Brien, in a field survey on 11/27/00, do hereby state that under requirements of P.A. 74, Michigan P.A. of 1970, the corner points mentioned in lines 1 and 2 above were in conformance with regulations and rules therefore as required in the current manual of survey instructions of the United States Department of the Interior, Bureau of Land Management or by a decree of a Court of Law and /or that the corner points mentioned in lines 3, 4 and 5 above were in conformance with the rules of the Michigan Board of Land Surveyors or by a Decree of a Court of Law; established, re-established, monumented, recovered, found as expressed below:

Grid table with columns A-M and rows 1-13. Contains numbers 1-36 in a grid pattern.

NOTE: Not more than 2 corners, all in the same town and range, may be recorded on this certificate.

A. Description of original monument and accessories and/or subsequent restoration:

April 1851 Algernon Merryweather, DS set corner 24 and 25 Balsam 6 in N50W 21 links Birch 10 in S45W 17 links.

1937 M.S.H.D. recovered original bearing tree 10" Birch S45°W 17 links. Added witnesses 6" Cedar N73°E 26.40' 6" Spruce S67°E 17.0'


March 1984 William F. Bowman LLS found axel shaft and 6" Cedar N73°E 26.4' as marked by M.S.H.D. survey crew in 1937. Replace axel shaft with 1" pipe and 4" Mead cap.

B. Description of corner evidence found and/or method applied in restoring or reestablishing corner:

Nov.27, 2000 Thomas P. O'Brien PS found 1" pipe with 4" Mead cap and LS 28406 stamp as set by Bowman. M.S.H.D. witness N73°E 26.4'.

C. Description of monument for corner and accessories established to perpetuate locating the position of the corner:

1" pipe with 4" Mead cap stamped to identify. Witnesses: 10" Cedar N13°W 31.90' 10" Cedar N64°E 13.95' Leaning 14" Cedar (M.S.H.D.) N79°E 25.35' to notch 12" Cedar S46°E 8.10' Carsonite Post North 1.0'

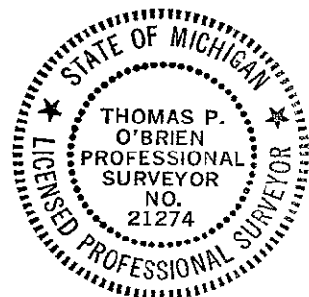

Signed by Thomas P. O'Brien Surveyor's Michigan License No. 21274

Date DEC. 27, 2000