

SCHOOLCRAFT COUNTY
PEER GROUP APPROVED

SURVEY &
REMONUMENTATION

DATE 10/10/00 *SB*

LAND CORNER RECORDATION CERTIFICATE
Filing Requirement of Act 74, Mich. P.A. 1970

FEB 08 2001

For corners in

SECTION

Schoolcraft (County)	Located In:	Corner Code #
1. Public Land Survey	T <u>42</u> N R <u>14</u> W	<u>M12</u>
	T ___ R ___	_____
	T ___ R ___	_____
	T ___ R ___	_____
2. Property Controlling in Section	S ___ T ___ R ___	_____
	S ___ T ___ R ___	_____
3. Miscellaneous Property in Sec.	S ___ T ___ R ___	_____
	S ___ T ___ R ___	_____

SIGRID HEDBERG 1P
SCHOOLCRAFT CO. REGISTER
Page 1 of 1 LC 4/424
JLV Date 12/28/2000 Time 11:28:16

Register of Deeds Stamp & File Number

4. Lot No. _____, Recorded Plat _____
5. Private Claims _____

I, Thomas P. O'Brien, in a field survey on 11/27/00 ~~to~~ do hereby state that under requirements of P.A. 74, Michigan P.A. of 1970, the corner points mentioned in lines 1 and 2 above were in conformance with regulations and rules therefore as required in the current manual of survey instructions of the United States Department of the Interior, Bureau of Land Management or by a decree of a Court of Law and /or that the corner points mentioned in lines 3, 4 and 5 above were in conformance with the rules of the Michigan Board of Land Surveyors or by a Decree of a Court of Law; established, re-established, monumented, recovered, found as expressed below:

NOTE: Not more than 2 corners, all in the same town and range, may be recorded on this certificate.

	A	B	C	D	E	F	G	H	I	J	K	L
1												
2	6		5		4		3		2		1	
3												
4	7		8		9		10		11		12	
5												
6	18		17		16		15		14		13	
7												
8	19		20		21		22		23		24	
9												
10	30		29		28		27		26		25	
11												
12	31		32		33		34		35		36	
13												

A. Description of original monument and accessories and/or subsequent restoration:

March 31, 1851 Algernon Merryweather DS set 1/4 post Birch 10 in N20W 28 lks
Hemlock 10" S49W 11 "

B. Description of corner evidence found and/or method applied in restoring or reestablishing corner:


Nov. 27, 2000 Thomas P. O'Brien PS set corner by single proportionate measure M13 to M11.

C. Description of monument for corner and accessories established to perpetuate locating the position of the corner:

Schoolcraft County monument stamped to identify.

Witnesses:

- 6" Balsam N25°E 8.80'
- 14" Cedar N57°E 28.10'
- 10" Cedar S59°E 30.85'
- A12 N0°07'29"W 41.65'
- Carsonite Post North 1.0'

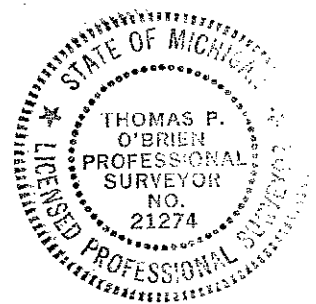

Signed by Thomas P. O'Brien
Surveyor's Michigan License No. 21274

Date Dec. 27, 2000