

**SCHOOLCRAFT COUNTY  
PEER GROUP APPROVED**

**SURVEY &  
REMONUMENTATION**

OCT 26 1995

**DATE** March 10, 1995 **LAND CORNER RECORDATION CERTIFICATE**

**COMMISSION**

For corners in TDS

Filing Requirement of Act 74, Mich. P.A. 1970

Schoolcraft <small>(County)</small>	Located In:	Corner Code #
1. Public Land Survey	T 42N R 15W T 42N R 16W T ___ R ___ T ___ R ___	<u>A-3</u> M-3
2. Property Controlling in Section	S ___ T ___ R ___ S ___ T ___ R ___	
3. Miscellaneous Property in Sec.	S ___ T ___ R ___ S ___ T ___ R ___	

Received & Filed this 10 day of  
March 19 95 at 2:31 p. M  
Sigrid I. Hedberg  
Schoolcraft Co. Reg. of Deeds

Register of Deeds Stamp & File Number

4. Lot No. \_\_\_\_\_, Recorded Plat \_\_\_\_\_  
5. Private Claims \_\_\_\_\_

A	B	C	D	E	F	G	H	I	J	K	L
2	6		5		4		3		2		1
3											
4	7		8		9		10		11		12
5											
6	16		17		16		15		14		13
7											
8	19		20		21		22		23		24
9											
10	30		29		28		27		26		25
11											
12	31		32		33		34		35		36
13											

I, Thomas P. O'Brien a field survey on Nov. 30, 1993

do hereby certify that under requirements of P.A. 74, Michigan P.A. of 1970, the corner points mentioned in lines 1 and 2 above were in conformance with regulations and rules therefore as required in the current manual of survey instructions of the United States Department of the Interior, Bureau of Land Management or by a decree of a Court of Law and/or that the corner points mentioned in lines 3, 4 and 5 above were in conformance with the rules of the Michigan Board of Land Surveyors or by a Decree of a Court of Law; established, re-established, monumented, re-monumented, recovered, found as expressed below:

**NOTE: Not more than 4 corners, all in the same town and range, may be recorded on this certificate.**

A. Description of original monument and accessories and/or subsequent restoration:


A-3(N.W. Corner Sec. 7)  
Aug. 3, 1845 John Burt D.S. set corner post.  
Hemlock 8 N65W 31 do 6 S15W 46  
Sept. 27/50 Algernon Merryweather, D.S. Corner 6&7 West Boundary  
Hemlock 20 in. S59E 51 links Spruce 10" N41E 33 "

B. Description of corner evidence found and/or method applied in restoring or reestablishing corner:

A-3 June 8, 1965 - Frank J. Bray, RLS set corner from rotted stumps of two probable BT's. Hemlock 6" S15W, 46 lks. and Hemlock 20" S59E 51 lks. Position checks good with distance South to swamp edge and stream. Old squared post in vicinity. Cedar register tree with names and dates back to 1940 near by. Distance South to Section Corner 80.76 chs., which is 76 lks. long but there seems to be a overrun throughout this township.  
Nov. 30, 1993 - Thomas P. O'Brien, PS recovered D.N.R. monument set by F. Bray. Bray witness 14" Y. Pine N54E 46 1/2 lks. cut.

C. Description of monument for corner and accessories established to perpetuate locating the position of the corner:

A-3 1" pipe w/4" aluminum cap stamped to identify.  
16" White Pine N27W 13 lks. (8.58') Bray witness.  
6" Cedar S28W 24 1/2 lks. (16.17') Bray witness.  
6" Cedar S54E 48.85' (NBT)

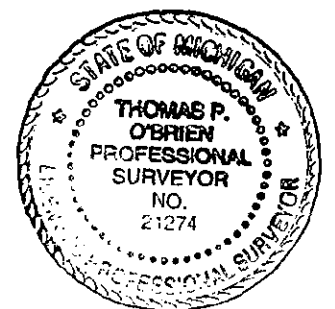

Signed by Thomas P. O'Brien, PS  
Surveyor's Michigan License No. 21274

Date March 10, 1995

LIBER 2 PAGE: 382