

**SCHOOLCRAFT COUNTY  
PEER GROUP APPROVED**

SURVEY &  
MONUMENTATION

LAND CORNER RECORDATION CERTIFICATE  
Filing Requirement of Act 74, Mich. P.A. 1970

OCT 26 1995

DATE March 10, 1995  
For corners in 005

COMMISSION

Schoolcraft (County)	Located In:	Corner Code #
1. Public Land Survey	T <u>42N</u> R <u>15W</u>	A-4 <u>A-5</u> ✓
	T <u>42N</u> R <u>16W</u>	M-4 M-5
	T _____ R _____	_____
	T _____ R _____	_____
2. Property Controlling in Section	S _____ T _____ R _____	_____
	S _____ T _____ R _____	_____
3. Miscellaneous Property in Sec.	S _____ T _____ R _____	_____
	S _____ T _____ R _____	_____

Received & Filed this 10 day of  
March 1995 at 2:35 p M  
Sigrid I. Hedberg  
Schoolcraft Co. Reg. of Deeds

Register of Deeds Stamp & File Number

4. Lot No. \_\_\_\_\_, Recorded Plat \_\_\_\_\_  
5. Private Claims \_\_\_\_\_

A	B	C	D	E	F	G	H	I	J	K	L	M
2	6	5	4	3	2	1						
3												
4	7	8	9	10	11	12						
5	*											
6	18	17	16	15	14	13						
7												
8	19	20	21	22	23	24						
9												
10	30	29	28	27	26	25						
11												
12	31	32	33	34	35	36						
13												

I, Thomas P. O'Brien in a field survey on Dec. 2 1993  
do hereby certify that under requirements of P.A. 74, Michigan P.A. of 1970, the corner points mentioned  
in lines 1 and 2 above were in conformance with regulations and rules therefore as required in the  
current manual of survey instructions of the United States Department of the Interior, Bureau of Land  
Management or by a decree of a Court of Law and/or that the corner points mentioned in lines 3, 4 and 5  
above were in conformance with the rules of the Michigan Board of Land Surveyors or by a Decree of a  
Court of Law; established, re-established, monumented, re-monumented, recovered, found as  
expressed below:

NOTE: Not more than 4 corners, all in the same town and range, may be recorded  
on this certificate.

A. Description of original monument and accessories and/or subsequent restoration:

A-4 (West 1/4 Corner Sec. 7)  
Aug. 3, 1845 John Burt, D.S. set qr. section post.  
Tamarack 5 N34E 7 Cedar 5 S41W 23

A-5 (N.W. Corner Sec. 18)  
Aug. 3, 1845 John Burt, D.S. set post corner  
Tamarack 6 N7W 32 do 5 S15W 42  
Sept. 25/50 Algernon Merryweather, D.S. corner 7&18 West Boundary  
Tamarack 10 in. S37E 25 links Cedar 6 in. N33E 27 "

B. Description of corner evidence found and/or method applied in restoring or reestablishing corner:

A-4 June 8, 1965 Frank J. Bray, RLS placed corner midway and on line between  
Section Corners., 40.378 Chs., North and the same distance South. No  
original evidence found.

Dec. 2, 1993 Thomas P. O'Brien, PS recovered D.N.R. monument set by F. Bray.


A-5 Sept. 17, 1964 Arthur O. Enger, RLS located corner pipe set by Carl Christensen  
from one original bearing tree, Tamarack 6 N7W 32 links, BT present in 1964,  
down, in poor condition, but scribe marks "r16, T42N, 12" legible on upper face

Dec. 2, 1993 Thomas P. O'Brien, PS recovered iron pipe w/brass cap set by  
Carl Christensen.

C. Description of monument for corner and accessories established to perpetuate locating the position of the corner:

A-4 1" pipe w/4" aluminum cap stamped to identify.  
12" Cedar S52E 22 lks. (14.52') Bray witness.  
8" Cedar N83W 26 lks. (17.16') Bray witness.  
6" Cedar S34W 24.90' (NBT)

A-5 2" iron pipe w/brass cap stamped to identify. " C.C "  
10" Cedar N58E 42 1/2 lks. (28.05') Enger Witness. 12 | 7  
10" Cedar S25E 30 lks. (19.80') Enger witness. 13 | 18  
10" Cedar S41W 60 lks. (39.60') Enger witness.

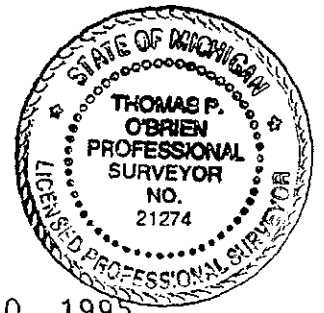

Signed by Thomas P. O'Brien, PS Date March 10, 1995

Surveyor's Michigan License No. 21274