

**SCHOOLCRAFT COUNTY
PEER GROUP APPROVED**

DATE 11/8/96 ^{JOB}

LAND CORNER RECORDATION CERTIFICATE
Filing Requirement of Act 74, Mich. P.A. 1970

SURVEY &
REMONUMENTATION

MAY 16 1997

For corners in

Schoolcraft
(County)

Located In:

Corner Code #

- | | | |
|------------------------------------|-------------------|--------------|
| 1. Public Land Survey | T <u>42NR15W</u> | <u>A-9</u> ✓ |
| | T <u>42NR16W</u> | <u>M-9</u> |
| | T ___ R ___ | _____ |
| | T ___ R ___ | _____ |
| 2. Property Controlling in Section | S ___ T ___ R ___ | _____ |
| | S ___ T ___ R ___ | _____ |
| 3. Miscellaneous Property in Sec. | S ___ T ___ R ___ | _____ |
| | S ___ T ___ R ___ | _____ |

COMMISSION

Received & Filed this 16 day of
December 19 96 at 11:55 A M
Sigrid I. Hedberg
Schoolcraft Co. Reg. of Deeds

Register of Deeds Stamp & File Number

4. Lot No. _____, Recorded Plat _____
5. Private Claims _____

I, Thomas P. O'Brien in a field survey on Oct. 29, 1996 do hereby state that under requirements of P.A. 74, Michigan P.A. of 1970, the corner points mentioned in lines 1 and 2 above were in conformance with regulations and rules therefore as required in the current manual of survey instructions of the United States Department of the Interior, Bureau of Land Management or by a decree of a Court of Law and /or that the corner points mentioned in lines 3, 4 and 5 above were in conformance with the rules of the Michigan Board of Land Surveyors or by a Decree of a Court of Law, established, re-established, monumented, recovered, found as expressed below:

NOTE: Not more than 2 corners, all in the same town and range, may be recorded on this certificate.

1	A	B	C	D	E	F	G	H	I	J	K	L	M
2		6		5		4		3		2		1	
3													
4		7		8		9		10		11		12	
5													
6		18		17		16		15		14		13	
7													
8		19		20		21		22		23		24	
9													
10		30		29		28		27		26		25	
11													
12		31		32		33		34		35		36	
13													

A. Description of original monument and accessories and/or subsequent restoration:

A-9 (N.W. Corner Sec. 30)
Aug. 3, 1845 John Burt D.S. set corner post.
Spruce 8 N27W 39 Tamarack 5 S80W 19

Sept. 21, 1850 - Algernon Merryweather D.S. Corner 19 & 30 West Boundary.
Tamarack 10" S75E 1.42 lks.

B. Description of corner evidence found and/or method applied in restoring or reestablishing corner:


A-9 Sept 8, 1987 - Gerald Wiggins, RLS. set a 1" pipe with 4" aluminum DNR cap " set by single proportionate measure along Township Line from original corners 1 mile North and 1 mile South."

Oct. 29, 1996 - Thomas P. O'Brien found a 1" pipe with 4" aluminum DNR cap stamped to identify, as set by Gerald L. Wiggins on Sept. 8, 1987.

C. Description of monument for corner and accessories established to perpetuate locating the position of the corner:

A-9 DNR monument stamped to identify.

Witnesses: Fd. 6" Dead Tamarack stub- S35°E - 55.50'
1/4 Corner, North, 2656.72'
1/4 Corner, South, 2656.72'
1/4 Corner, West, 2659.13'
No witnesses available-corner in marsh

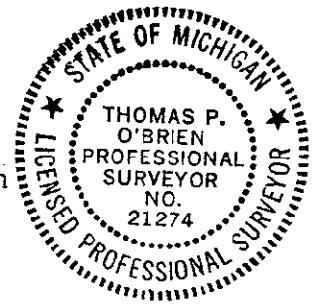

Thomas P. O'Brien

Signed by Thomas P. O'Brien

Date Nov. 14, 1996

Surveyor's Michigan License No. 21274