

**SCHOOLCRAFT COUNTY
PEER GROUP APPROVED**

**SURVEY &
REMONUMENTATION**

DATE 11/8/96 ^{JOB}

LAND CORNER RECORDATION CERTIFICATE
Filing Requirement of Act 74, Mich. P.A. 1970

MAY 16 1997

For corners in

COMMISSION

| | | |
|---------------------------------------|--------------|---------------|
| <u>Schoolcraft</u> (County) | Located In: | Corner Code # |
| 1. Public Land Survey | T42NR 15W | <u>A-10</u> ✓ |
| | T42NR 16W | M-10 |
| | T___R___ | _____ |
| | T___R___ | _____ |
| 2. Property Controlling in Section | S___T___R___ | _____ |
| | S___T___R___ | _____ |
| 3. Miscellaneous Property in Sec. | S___T___R___ | _____ |
| | S___T___R___ | _____ |

Received & Filed this 16 day of
December 19 96 at 11:54 AM
Sigrid I. Hedberg
Schoolcraft Co. Reg. of Deeds

Register of Deeds Stamp & File Number

4. Lot No. _____, Recorded Plat _____
5. Private Claims _____

| | | | | | | | | | | | | | |
|----|----|---|----|---|----|---|----|---|----|---|----|---|---|
| 1 | A | B | C | D | E | F | G | H | I | J | K | L | M |
| 2 | 6 | | 5 | | 4 | | 3 | | 2 | | 1 | | |
| 3 | | | | | | | | | | | | | |
| 4 | 7 | | 8 | | 9 | | 10 | | 11 | | 12 | | |
| 5 | | | | | | | | | | | | | |
| 6 | 18 | | 17 | | 16 | | 15 | | 14 | | 13 | | |
| 7 | | | | | | | | | | | | | |
| 8 | 19 | | 20 | | 21 | | 22 | | 23 | | 24 | | |
| 9 | | | | | | | | | | | | | |
| 10 | 30 | | 29 | | 28 | | 27 | | 26 | | 25 | | |
| 11 | | | | | | | | | | | | | |
| 12 | 31 | | 32 | | 33 | | 34 | | 35 | | 36 | | |
| 13 | | | | | | | | | | | | | |


I, Thomas P. O'Brien in a field survey on Oct. 29 19 96 do hereby state that under requirements of P.A. 74, Michigan P.A. of 1970, the corner points mentioned in lines 1 and 2 above were in conformance with regulations and rules therefore as required in the current manual of survey instructions of the United States Department of the Interior, Bureau of Land Management or by a decree of a Court of Law and /or that the corner points mentioned in lines 3, 4 and 5 above were in conformance with the rules of the Michigan Board of Land Surveyors or by a Decree of a Court of Law; established, re-established, monumented, recovered, found as expressed below:

NOTE: Not more than 2 corners, all in the same town and range, may be recorded on this certificate.

A. Description of original monument and accessories and/or subsequent restoration:
A-10 (West 1/4 Corner Sec. 30)
Aug. 3, 1845 John Burt D.S. set qr. section post.
Cedar 12 N66W 39 Fir 9 S74W 25

B. Description of corner evidence found and/or method applied in restoring or reestablishing corner:
A-10 Sept. 8, 1987 - Gerald L. Wiggins, RLS. set corner " midpoint and on line between N.E. Corner and S.E. Corner of section 25. 3 river crossings match original measure. Found Cedar stump bottom that fits original bearing and distance Cedar 12, N66°W, 39 lks.
October 29, 1996 - Thomas P. O'Brien P.S. recovered 1" pipe with 4" aluminum DNR cap stamped to identify, as set by Gerald L. Wiggins on Sept. 8, 1987.

C. Description of monument for corner and accessories established to perpetuate locating the position of the corner:
A-10 DNR Monument
Witnesses: Fd. 14" Maple - S72°E - 9.90' Ex. Cond.
" 8" Cedar - N12°W - 23.10' " "
" 22" Cedar - N30°W - 19.40' " "
" 6" Ash - N85°W - 10.60' " "
4" Cedar Post - West - 2.0'

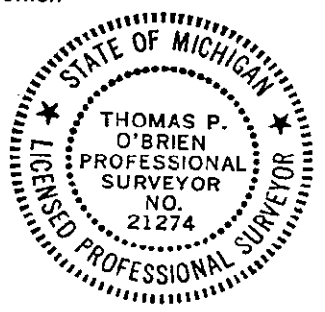

Signed by Thomas P. O'Brien Date Nov. 18, 1996
Surveyor's Michigan License No. 21274