

**SCHOOLCRAFT COUNTY
PEER GROUP APPROVED**

SURVEY &
REMONUMENTATION

MAY 16 1997

DATE 7/12/96 LAND CORNER RECORDATION CERTIFICATE
Filing Requirement of Act 74, Mich. P.A. 1970

COMMISSION

For corners in

<u>Schoolcraft</u> (County)	Located In:	Corner Code #
1. Public Land Survey	T42NR15W T42NR16W T___R___ T___R___	<u>A-11</u> <u>M-11</u> _____ _____
2. Property Controlling in Section	S___ T___ R___ S___ T___ R___	_____ _____
3. Miscellaneous Property in Sec.	S___ T___ R___ S___ T___ R___	_____ _____

Received & Filed this 16 day of
December 1996 at 11:53 AM
Sigrid I. Hedberg
Schoolcraft Co. Reg. of Deeds

Register of Deeds Stamp & File Number

4. Lot No. _____, Recorded Plat _____
5. Private Claims _____

A	B	C	D	E	F	G	H	I	J	K	L	M
1												
2	6		5		4		3		2		1	
3												
4	7		8		9		10		11		12	
5												
6	10		17		16		15		14		13	
7												
8	19		20		21		22		23		24	
9												
10	30		29		28		27		26		25	
11												
12	31		32		33		34		35		36	
13												

I, Thomas P. O'Brien in a field survey on Oct. 25, 1996 do hereby state that under requirements of P.A. 74, Michigan P.A. of 1970, the corner points mentioned in lines 1 and 2 above were in conformance with regulations and rules therefore as required in the current manual of survey instructions of the United States Department of the Interior, Bureau of Land Management or by a decree of a Court of Law and/or that the corner points mentioned in lines 3, 4 and 5 above were in conformance with the rules of the Michigan Board of Land Surveyors or by a Decree of a Court of Law; established, re-established, monumented, recovered, found as expressed below:

NOTE: Not more than 2 corners, all in the same town and range, may be recorded on this certificate.

A. Description of original monument and accessories and/or subsequent restoration:

A-11 (N.W. Corner Sec. 31)
Aug. 3, 1845 John Burt D.S. set corner post.
Cedar 20 N45W 36 do 14 S66W 4

Sept. 20, 1850 Algernon Merryweather, D.S. Corner 30&31 West Boundary.
Birch 10 in. N40E 15 lks. S. Maple 20" S70E 42"


B. Description of corner evidence found and/or method applied in restoring or reestablishing corner:

A-11 Feb. 20, 1957 - Billy D. Buckler, R.L.S. found 1" pipe with brass cap set by Carl Christensen from " Cedar B.T. bears S45W 4 links."

Oct. 25, 1996 - Thomas P. O'Brien, P.S. recovered iron pipe with brass cap as set by Carl Christensen from an original bearing tree " Cedar 14" S66W 4 links" as noted in County Surveyors book. Original B.T. has been cut, stump is tipped, but still in good condition.

C. Description of monument for corner and accessories established to perpetuate locating the position of the corner:

A-11 1" pipe with 4" brass cap stamped to identify.
Witnesses: Fd. 9" Cedar- S60°E- 66 lks.
" 8" Cedar- S26°W- 48½ lks.
" 10" Cedar- N60°W- 64 lks.
NBT 10" Maple- N57°E- 61.38'
OBT 14" Cedar Stump- S45°W - 4 lks.
4" Cedar post - East - 1.0'

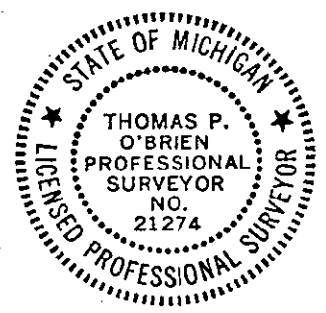

Thomas P. O'Brien

Signed by Thomas P. O'Brien
Surveyor's Michigan License No. 21274

Date Nov. 18, 1996