SCHOOLCRAFT COUNTY
PEER GROUP APPROVED
DATE Dec. 7, 1995

JAN 30 1996
COMMISSION

LAND CORNER RECORDATION CERTIFICATE

Filing Requirement of Act 74, Mich. P.A. 1970

For corners in Schoolcraft (County)

	Located In:	Corner Code ##
1. Public Land Survey	T 42 N R 15 W	B-13 ✓
	T 41 N R 15 W	B-1
	T ___ R ___	
	T ___ R ___	
2. Property Controlling	S ___ T ___ R ___	
in Section	S ___ T ___ R ___	
3. Miscellaneous	S ___ T ___ R ___	
Property in Sec.	S ___ T ___ R ___	

Received & Filed this 26 day of Dec. 1995 at 2:36 P M
Sigrid I. Hedberg
Schoolcraft Co. Reg. of Deeds

Register of Deeds Stamp & File Number

4. Lot No. _____, Recorded Plat _____
5. Private Claims _____

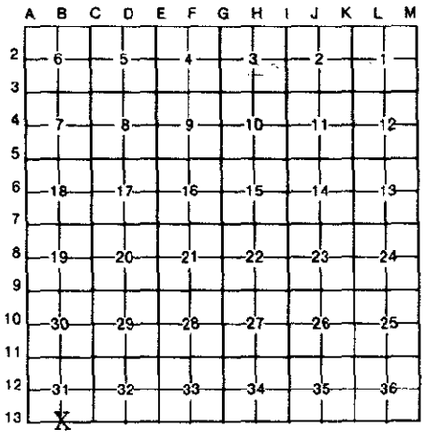

I, Thomas P. O'Brien, in a field survey on Oct. 6, 19 94, do hereby certify that under requirements of P.A. 74, Michigan P.A. of 1970, the corner points mentioned in lines 1 and 2 above were in conformance with regulations and rules therefore as required in the current manual of survey instructions of the United States Department of the Interior, Bureau of Land Management or by a decree of a Court of Law and/or that the corner points mentioned in lines 3, 4 and 5 above were in conformance with the rules of the Michigan Board of Land Surveyors or by a Decree of a Court of Law; established, re-established, monumented, re-monumented, recovered, found as expressed below:

NOTE: Not more than 4 corners, all in the same town and range, may be recorded on this certificate.

A. Description of original monument and accessories and/or subsequent restoration:

B-13 (South 1/4 Corner Sec.31)
Aug. 6, 1845 John Burt D.S. set qr. section post.
Hemlock 32 N42E 19

B. Description of corner evidence found and/or method applied in restoring or reestablishing corner:

B-13 Feb.14, 1989 Gerald L. Wiggins, RLS set corner "record distance and bearing from remains of large Hemlock stump."

Oct. 6, 1994 Thomas P. O'Brien, PS recovered a 1¼" iron pipe w/4" aluminum DNR cap as set by Gerald L. Wiggins, RLS. Accepted corner position as monumented . Hemlock stump present in good condition.

C. Description of monument for corner and accessories established to perpetuate locating the position of the corner:

B13 Pipe w|4" aluminum cap stamped to identify. DNR cap.
Witnesses:
8" Cedar S48°E 12.30'
8" Cedar N58°E 12.20'
8" Cedar N9°W 27.40'
5" Cedar N40°W 14.00'

STATE OF MICHIGAN
THOMAS P. O'BRIEN
PROFESSIONAL SURVEYOR
NO. 21274
LICENSED PROFESSIONAL SURVEYOR

Signed by Thomas P. O'Brien Date Dec. 20, 1995

Surveyor's Michigan License No. 21274

LIBER 4 PAGE: 24

FORM APPROVED BY MICHIGAN STATE BOARD OF LAND SURVEYORS, JAN. 28, 1971
REVISED MAY 14, 1975
REVISED JAN., 1983