

OCT 26 1995

COMMISSION

SCHOOLCRAFT COUNTY PEER GROUP APPROVED

LAND CORNER RECORDATION CERTIFICATE

Filing Requirement of Act 74, Mich. P.A. 1970

DATE March 10, 1995

For corners in Schoolcraft (County) DOB

Located In:

Corner Code #

- 1. Public Land Survey T 42N R 15W B-1 C-1
T 43N R 15W B-13 C-13
- 2. Property Controlling in Section S ___ T ___ R ___
- 3. Miscellaneous Property in Sec. S ___ T ___ R ___

Received & Filed this 10 day of March 1995 at 2:34 pM
Sigrid I. Hedberg
Schoolcraft Co. Reg. of Deeds

Register of Deeds Stamp & File Number

- 4. Lot No. _____, Recorded Plat _____
- 5. Private Claims _____

	A	B	C	D	E	F	G	H	I	J	K	L	M
2	6	5	4	3	2	1							
3													
4	7	8	9	10	11	12							
5													
6	18	17	16	15	14	13							
7													
8	19	20	21	22	23	24							
9													
10	30	29	28	27	26	25							
11													
12	31	32	33	34	35	36							
13													

I, Thomas P.O'Brien, in a field survey on Nov.23, 1993, do hereby certify that under requirements of P.A. 74, Michigan P.A. of 1970, the corner points mentioned in lines 1 and 2 above were in conformance with regulations and rules therefore as required in the current manual of survey instructions of the United States Department of the Interior, Bureau of Land Management or by a decree of a Court of Law and/or that the corner points mentioned in lines 3, 4 and 5 above were in conformance with the rules of the Michigan Board of Land Surveyors or by a Decree of a Court of Law; established, re-established, monumented, re-monumented, recovered, found as expressed below:

NOTE: Not more than 4 corners, all in the same town and range, may be recorded on this certificate.

A. Description of original monument and accessories and/or subsequent restoration:


- B-1 (North 1/4 Corner Sec.6)
Oct.25, 1841 - William A. Burt, D.S. Set qr. section post.
Beech 10 N28E 26 Do 10 N27W 20
- C-1 (N.E. Corner Sec.6)
Oct.25, 1841 - William A. Burt, D.S. Set corner post.
Maple 8 N51E 30 Hemlock 18 N52W 20
Sept.27, 1850 - Algernon Merryweather, D.S. Corner 5&6 North Boundary
Hemlock 20 in S69E 23 links Do 10" S43W 30"

B. Description of corner evidence found and/or method applied in restoring or reestablishing corner:

- B-1 Oct.16, 1967 - Frank J. Bray, RLS placed the corner on line and the single proportioned measurement between section corners to east and town corner to west. No original evidence found.
Nov.23, 1993 - Thomas P. O'Brien, PS recovered D.N.R. monument set by F. Bray.
- C-1 Oct.16, 1967 - Frank J. Bray, RLS placed the corner on line and the single proportioned measurement between section corner to east and town corner to west. No original evidence found.
Nov.23, 1993 - Thomas P.O'Brien, PS recovered D.N.R. monument set by F. Bray.

C. Description of monument for corner and accessories established to perpetuate locating the position of the corner:

- B-1 1" pipe w/4" aluminum cap stamped to identify.
10" White Pine S47E 101.75' (NBT)
8" Maple S39W 47 links (31.02') Bray witness.
12" Aspen N60E 68 1/2 links (45.21') Bray witness.
4" Cherry N14E 82.50' (NBT)
- C-1 1" pipe w/4" aluminum cap stamped to identify.
6" Maple S58E 31.90' (NBT)
10" Maple N25W 13 links (8.58') Bray witness.
8" Maple S1E 68 links (44.88') Bray witness.

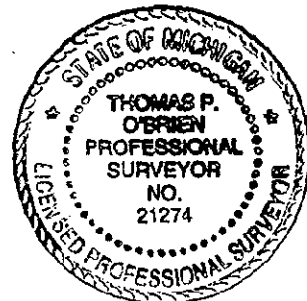

Signed by Thomas P.O'Brien, PS Date March 10, 1995

Surveyor's Michigan License No. 21274