

**SCHOOLCRAFT COUNTY  
PEER GROUP APPROVED**

JAN 30 1996

**DATE** May 12, 1995 **LAND CORNER RECORDATION CERTIFICATE**  
Filing Requirement of Act 74, Mich. P.A. 1970

COMMISSION

For corners in

<u>Schoolcraft</u> (County)	Located In:	Corner Code #
1. Public Land Survey	T <u>42N</u> R <u>15W</u>	<u>C-9</u> ✓ <u>C-10</u>
	T <u>42N</u> R <u>15W</u>	
	T _____ R _____	
	T _____ R _____	
2. Property Controlling in Section	S _____ T _____ R _____	
	S _____ T _____ R _____	
3. Miscellaneous Property in Sec.	S _____ T _____ R _____	
	S _____ T _____ R _____	

Received & Filed this 6 day of  
Dec. 1995 at 11:45 A M  
Sigrid I. Hedberg  
Schoolcraft Co. Reg. of Deeds

Register of Deeds Stamp & File Number

4. Lot No. \_\_\_\_\_, Recorded Plat \_\_\_\_\_  
5. Private Claims \_\_\_\_\_

A	B	C	D	E	F	G	H	I	J	K	L	M
2	6	5	4	3	2	1						
3												
4	7	8	9	10	11	12						
5												
6	18	17	16	15	14	13						
7												
8	19	20	21	22	23	24						
9												
10	30	29	28	27	26	25						
11												
12	31	32	33	34	35	36						
13												

I, Thomas P. O'Brien in a field survey on c-9 Nov. 8, 95  
c-10 Nov. 8, 95  
do hereby certify that under requirements of P.A. 74, Michigan P.A. of 1970, the corner points mentioned in lines 1 and 2 above were in conformance with regulations and rules therefore as required in the current manual of survey instructions of the United States Department of the Interior, Bureau of Land Management or by a decree of a Court of Law and/or that the corner points mentioned in lines 3, 4 and 5 above were in conformance with the rules of the Michigan Board of Land Surveyors or by a Decree of a Court of Law; established, re-established, monumented, re-monumented, recovered, found as expressed below:

**NOTE: Not more than 4 corners, all in the same town and range, may be recorded on this certificate.**

A. Description of original monument and accessories and/or subsequent restoration:


- C-9 (Section Corner common to sections 19, 20, 29, 30)  
Sept. 21, 1850 Algernon Merryweather D.S. set corner post.  
Cedar 14 in. N10E 19 links Cedar 12" S20W 37 "
- C-10 (1/4 corner common to Sec.s 29 & 30)  
Sept. 21, 1850 Algernon Merryweather set corner post.  
Cedar 9 N43W 17 lks. Cedar 12 S54E 17 lks.

B. Description of corner evidence found and/or method applied in restoring or reestablishing corner:

- C-9 Feb. 14, 1989 Gerald L. Wiggins, RLS "corner set and witnessed as set by A.O. Enger L.S. #13581 Nov. 19, 1962 from one original bearing tree, Cedar 12" N10E, 19 lks."  
Oct. 5, 1994 Thomas P. O'Brien, PS recovered 1" pipe w/ 4" aluminum DNR cap as set by Gerald L. Wiggins, RLS. Found cedar stump N10°E 12.54'.
- C-10 Feb. 14, 1989 Gerald L. Wiggins, RLS "corner set by single proportionate measurement between N.E. Corner and S.E. Corner of Section 30. Both Section Corners were set from original evidence."  
Oct. 5, 1994 Thomas P. O'Brien, PS recovered 1" pipe w/ 4" aluminum DNR cap set by Gerald L. Wiggins, RLS. Recovered witnesses verify corner position.

C. Description of monument for corner and accessories established to perpetuate locating the position of the corner:

- C-9 1" pipe w/ 4" aluminum cap stamped to identify.  
& Recovered witnesses as established by G. Wiggins, L2-P224 in good condition.
- C-10 Witnesses: C-9  
6" Cedar S60°W 3.35'  
10" Cedar N20°W 20.6'  
5" Cedar N35°E 28.95'  
6" Cedar S14°E 19.65'
- Witnesses: C-10  
8" Cedar N37°E 14.0'  
8" Cedar N73°E 21.9'  
10" Cedar N88°W 10.95'  
5" Cedar S18°E 10.1'

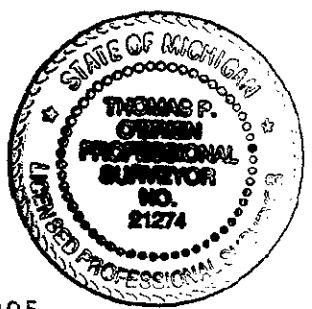

Signed by Thomas P. O'Brien, PS Date Dec. 4, 1995  
Surveyor's Michigan License No. 21274