

**SCHOOLCRAFT COUNTY
PEER GROUP APPROVED**

DATE 11/8/96 ^{JOB}

LAND CORNER RECORDATION CERTIFICATE
Filing Requirement of Act 74, Mich. P.A. 1970

**SURVEY &
REMONUMENTATION**

MAY 16 1997

COMMISSION

For corners in

<u>Schoolcraft</u> (County)	Located In:	Corner Code #
1. Public Land Survey	T <u>4</u> N <u>1</u> S <u>W</u>	<u>D-3</u>
	T___R___	_____
	T___R___	_____
	T___R___	_____
2. Property Controlling in Section	S___T___R___	_____
	S___T___R___	_____
3. Miscellaneous Property in Sec.	S___T___R___	_____
	S___T___R___	_____

Received & Filed this 16 day of
December 19 96 at 11:48 AM
Sigrid I. Hedberg
Schoolcraft Co. Reg. of Deeds

Register of Deeds Stamp & File Number

4. Lot No. _____, Recorded Plat _____
5. Private Claims _____

I, Thomas P. O'Brien, in a field survey on Nov. 12, 19 96 do hereby state that under requirements of P.A. 74, Michigan P.A. of 1970, the corner points mentioned in lines 1 and 2 above were in conformance with regulations and rules therefore as required in the current manual of survey instructions of the United States Department of the Interior, Bureau of Land Management or by a decree of a Court of Law and /or that the corner points mentioned in lines 3, 4 and 5 above were in conformance with the rules of the Michigan Board of Land Surveyors or by a Decree of a Court of Law; established, re-established, monumented, recovered, found as expressed below:

NOTE: Not more than 2 corners, all in the same town and range, may be recorded on this certificate.

1	A	B	C	D	E	F	G	H	I	J	K	L	M
2		6		5		4		3		2		1	
3				X									
4		7		8		9		10		11		12	
5													
6		18		17		16		15		14		13	
7													
8		19		20		21		22		23		24	
9													
10		30		29		28		27		26		25	
11													
12		31		32		33		34		35		36	
13													

A. Description of original monument and accessories and/or subsequent restoration:

D-3 (N 1/4 Corner Sec. 8)
Sept. 26, 1850 - Algernon Merryweather D.S. set qr. section post.
Beech 8 in. N32W 3 links Beech 7 in. S61E 12 links


B. Description of corner evidence found and/or method applied in restoring or reestablishing corner:

D-3 Nov. 12, 1996 - Thomas P. O'Brien, P.S. re-established corner by single proportionate measurement. No evidence of G.L.O. survey or subsequent restoration recovered.

C. Description of monument for corner and accessories established to perpetuate locating the position of the corner:

D-3 Schoolcraft County Monument stamped to identify.

Witnesses: 12" Cherry - N14°W - 99.10'
8" Maple - S21°E - 109.37'
8" Maple - S52°W - 86.44'
16" W. Pine - N63°W - 116.51'
4" Cedar Post - North - 2.0'

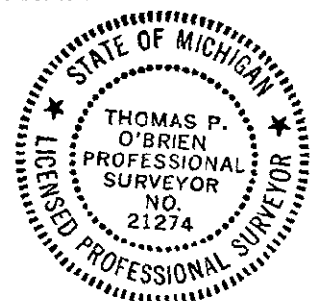

Thomas P. O'Brien

Signed by Thomas P. O'Brien
Surveyor's Michigan License No. 21274

Date Nov. 20, 1996