

SCHOOLCRAFT COUNTY PEER GROUP APPROVED

MAY 16 1997

COMMISSION

DATE 11/8/96 LAND CORNER RECORDATION CERTIFICATE Filing Requirement of Act 74, Mich. P.A. 1970

For corners in

Schoolcraft (County) Located in: Corner Code # 1. Public Land Survey T42NR15W E-10 2. Property Controlling in Section S T R 3. Miscellaneous Property in Sec. S T R

Received & Filed this 16 day of December 1996 at 11:56 AM Sigrid I. Hedberg Schoolcraft Co. Reg. of Deeds

Register of Deeds Stamp & File Number

4. Lot No. , Recorded Plat 5. Private Claims

I, Thomas P. O'Brien in a field survey on Nov. 25, 1996 do hereby state that under requirements of P.A. 74, Michigan P.A. of 1970, the corner points mentioned in lines 1 and 2 above were in conformance with regulations and rules therefore as required in the current manual of survey instructions of the United States Department of the Interior, Bureau of Land Management or by a decree of a Court of Law and/or that the corner points mentioned in lines 3, 4 and 5 above were in conformance with the rules of the Michigan Board of Land Surveyors or by a Decree of a Court of Law; established, re-established, monumented, recovered, found as expressed below:

Grid table with columns A-M and rows 1-13. Cell (10, F) contains an 'X'.

NOTE: Not more than 2 corners, all in the same town and range, may be recorded on this certificate.

A. Description of original monument and accessories and/or subsequent restoration:

E-10 (E 1/4 Corner Sec. 29) Sept. 21, 1850 - Algernon Merryweather D.S. set qr. section post. Hemlock 30 in. S65E 2 links do. 20 in. N55W 31 links


B. Description of corner evidence found and/or method applied in restoring or reestablishing corner:

E-10 Nov. 25, 1996 - Thomas P. O'Brien, P.S. re-established corner by single proportionate measurement. No evidence of G.L.O. survey or subsequent restoration recovered.

C. Description of monument for corner and accessories established to perpetuate locating the position of the corner:

E-10 Schoolcraft County monument stamped to identify.

- Witnesses: 6" Maple - N20°W - 7.0' 6" Maple - N52°E - 34.83' 6" Maple - S51°E - 44.66' 6" Maple - S72°W - 18.40' 4" Cedar post - North - 2.0'

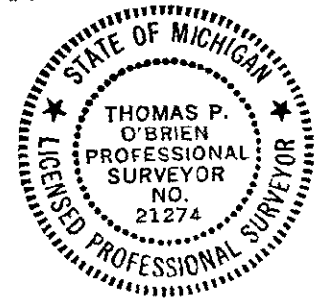

Signed by Thomas P. O'Brien Surveyor's Michigan License No. 21274

Date Nov. 29, 1996