SCHOOLCRAFT COUNTY
PEER GROUP APPROVED
DATE Dec. 7, 1995

JAN 30 1996
COMMISSION

LAND CORNER RECORDATION CERTIFICATE

~~Filing~~ Requirement of Act 74, Mich. P.A. 1970

For corners in Schoolcraft (County)

	Located In:	Corner Code ##
1. Public Land Survey	T 42N R 15W	G2
	T ___ R ___	
	T ___ R ___	
	T ___ R ___	
2. Property Controlling	S ___ T ___ R ___	
in Section	S ___ T ___ R ___	
3. Miscellaneous	S ___ T ___ R ___	
Property in Sec.	S ___ T ___ R ___	

Received & Filed this 28 day of Dec. 1995 at 2:51 p M
Sigrid I. Hedberg
Schoolcraft Co. Reg. of Deeds

Register of Deeds Stamp & File Number

4. Lot No. _____, Recorded Plat _____
5. Private Claims _____

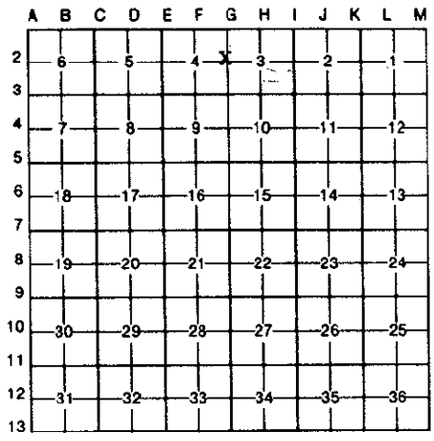

I, Thomas P.O'Brien, in a field survey on Aug.22, 19 95, do hereby certify that under requirements of P.A. 74, Michigan P.A. of 1970, the corner points mentioned in lines 1 and 2 above were in conformance with regulations and rules therefore as required in the current manual of survey instructions of the United States Department of the Interior, Bureau of Land Management or by a decree of a Court of Law and/or that the corner points mentioned in lines 3, 4 and 5 above were in conformance with the rules of the Michigan Board of Land Surveyors or by a Decree of a Court of Law; established, re-established, monumented, re-monumented, recovered, found as expressed below:

NOTE: Not more than 4 corners, all in the same town and range, may be recorded on this certificate.

A. Description of original monument and accessories and/or subsequent restoration:

Sept.19, 1850 Algernon Merryweather "set 1/4 post Cedar 12 in N31W 13 links do 8 in S27E 11 links.
May 25, 1950 Carl Christensen set 2" pipe w/21/2" brass cap N27E 13 links(8.58') from 12" cedar and recorded on page 113 Schoolcraft County Surveyor's Record.

B. Description of corner evidence found and/or method applied in restoring or reestablishing corner:

Aug.22,1995 Thomas P.O'Brien, PS recovered 2" pipe w2 1/2" brass cap set by Carl Christensen and verified by cedar stump remains S27W 13 links.

C. Description of monument for corner and accessories established to perpetuate locating the position of the corner:

2" pipe w/2 1/2 brass cap stamped to identify.
Witnesses:
12" Cedar S80°W 9.45'
10" Cedar N28°W 19.66'
10" Cedar N48°E 45.0'
8" Cedar S20°E 18.95'
Cedar Post North 1.0'

STATE OF MICHIGAN
THOMAS P. O'BRIEN
PROFESSIONAL SURVEYOR
NO. 21274
LICENSED PROFESSIONAL SURVEYOR

Signed by Thomas P.O'Brien Date Dec.28, 1995

Surveyor's Michigan License No. 21274

LIBER 4 PAGE: 32

FORM APPROVED BY MICHIGAN STATE BOARD OF LAND SURVEYORS, JAN. 28, 1971
REVISED MAY 14, 1975
REVISED JAN., 1983