

**SCHOOLCRAFT COUNTY
PEER GROUP APPROVED**

DATE May 12, 1995 **LAND CORNER RECORDATION CERTIFICATE**
Filing Requirement of Act 74, Mich. P.A. 1970

JAN 30 1996
COMMISSION

For corners in

<u>Schoolcraft</u> <small>(County)</small>	Located In:	Corner Code #
1. Public Land Survey	T <u>42N</u> R <u>15W</u>	<u>G-3</u>
	T _____ R _____	_____
	T _____ R _____	_____
	T _____ R _____	_____
2. Property Controlling in Section	S _____ T _____ R _____	_____
	S _____ T _____ R _____	_____
3. Miscellaneous Property in Sec.	S _____ T _____ R _____	_____
	S _____ T _____ R _____	_____
4. Lot No. _____, Recorded Plat _____		
5. Private Claims _____		

Received & Filed this 6th day of
Dec. 1995 at 11:36 AM
Sigrid I. Hedberg
Schoolcraft Co. Reg. of Deeds
Register of Deeds Stamp & File Number

I, Thomas P. O'Brien in a field survey on Nov. 30, 1993
do hereby certify that under requirements of P.A. 74, Michigan P.A. of 1970, the corner points mentioned
in lines 1 and 2 above were in conformance with regulations and rules therefore as required in the
current manual of survey instructions of the United States Department of the Interior, Bureau of Land
Management or by a decree of a Court of Law and/or that the corner points mentioned in lines 3, 4 and 5
above were in conformance with the rules of the Michigan Board of Land Surveyors or by a Decree of a
Court of Law; established, re-established, monumented, re-monumented, recovered, found as
expressed below:

	A	B	C	D	E	F	G	H	I	J	K	L	M
2	6	5	4	3	2	1							
3				X									
4	7	8	9	10	11	12							
5													
6	18	17	16	15	14	13							
7													
8	19	20	21	22	23	24							
9													
10	30	29	28	27	26	25							
11													
12	31	32	33	34	35	36							
13													

NOTE: Not more than 4 corners, all in the same town and range, may be recorded on this certificate.

A. Description of original monument and accessories and/or subsequent restoration:


G-3 (Section Corner common to sections 3,4,9,10)
Cedar 12 in. S41E 14 links do 8 "N48W 21 "

B. Description of corner evidence found and/or method applied in restoring or reestablishing corner:

G-3 May 25, 1950 Carl Christensen set 2 1/2" iron pipe with brass cap from 2 original witness trees " Cedar 8" N48W 21 links, Cedar 12 " S41E 14 links " as noted in County Surveyors book.
June 26, 1991 Gerald L. Wiggins, RLS rewitnessed corner as set by Carl Christensen.
Nov. 30, 1993 Thomas P. O'Brien recovered 2 1/2" pipe w/brass cap as set by Carl Christensen.

C. Description of monument for corner and accessories established to perpetuate locating the position of the corner:

G-3 2 1/2" pipe w/brass cap stamped to identify by "CC". (As on cap)
Witnesses: (Recovered witnesses by G. Wiggins)
6" cedar S76°W 13.40'
6" Cedar East 17.40'
10" Cedar N37°e 21.10'
8" Cedar N63°W 29.30'

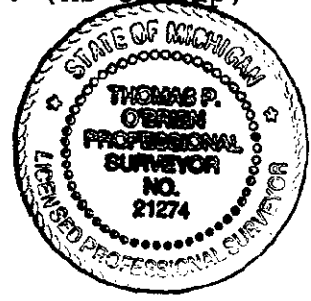

Signed by Thomas P. O'Brien, PS Date Dec. 4, 1995
Surveyor's Michigan License No. 21274