

NOV 21 1996

COMMISSION

SCHOOLCRAFT COUNTY
PEER GROUP APPROVED

DATE 7/12/96 ^{JOBS} LAND CORNER RECORDATION CERTIFICATE
Filing Requirement of Act 74, Mich. P.A. 1970

For corners in

Schoolcraft (County)	Located In:	Corner Code #
1. Public Land Survey	T42NR15W	G-12
	T ___ R ___	_____
	T ___ R ___	_____
	T ___ R ___	_____
2. Property Controlling in Section	S ___ T ___ R ___	_____
	S ___ T ___ R ___	_____
3. Miscellaneous Property in Sec.	S ___ T ___ R ___	_____
	S ___ T ___ R ___	_____

Received & Filed this 8th day of
October 19 96 at 11:32 A M

Sigrid I. Hedberg
Schoolcraft Co. Reg. of Deeds

Register of Deeds Stamp & File Number

4. Lot No. _____, Recorded Plat _____
5. Private Claims _____

Thomas P. O'Brien in a field survey on Aug. 14, 1996 do hereby state that under requirements of P.A. 74, Michigan P.A. of 1970, the corner points mentioned in lines 1 and 2 above were in conformance with regulations and rules therefore as required in the current manual of survey instructions of the United States Department of the Interior, Bureau of Land Management or by a decree of a Court of Law and for that the corner points mentioned in lines 3, 4 and 5 above were in conformance with the rules of the Michigan Board of Land Surveyors or by a Decree of a Court of Law; established, re-established, monumented, recovered, found as expressed below:

NOTE: Not more than 2 corners, all in the same town and range, may be recorded on this certificate.

A	B	C	D	E	F	G	H	I	J	K	L	M
1												
2	6		5		4		3		2		1	
3												
4	7		8		9		10		11		12	
5												
6	18		17		16		15		14		13	
7												
8	19		20		21		22		23		24	
9												
10	30		29		28		27		26		25	
11												
12	31		32		33		34		35		36	
13												

A. Description of original monument and accessories and/or subsequent restoration:

G-12 (E 1/4 Corner of Section 33)
Sept. 18, 1850 Algernon Merryweather D.S. set gr. section post.
Tamarack 8 in. S50E 15 links Tamarack 9" N35W 9"

SURVEY & REMONUMENTATION

DEC 18 1896

B. Description of corner evidence found and/or method applied in restoring or reestablishing corner:


G-12 June 30, 1983 Donald r. Schofield RLS set 3/8" reinforcing rod with Schofield cap #25871 by single proportionate measurement between G-11 and G-13 as noted in Liber 1 pg. 334.

August 14, 1996 Thomas P.O'Brien P.S. recovered 3/8" iron rod with Schofield cap #25871, accepted corner position and replaced with Schoolcraft County monument.

C. Description of monument for corner and accessories established to perpetuate locating the position of the corner:

G-12 Set Schoolcraft County monument stamped to identify.

- Witnesses:
- 6" Cedar - N10°W - 21.50'
 - 6" Tamarack - N47°E - 77.27'
 - 3" Tamarack - S18°E - 13.03'
 - 6" Tamarack - S71°W - 13.23'
 - 4" Cedar post - N4°E - 2.0'

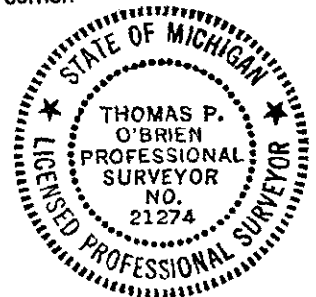

Signed by Thomas P. O'Brien
Surveyor's Michigan License No. 21274

Date August 14, 1996