

SCHOOLCRAFT COUNTY PEER GROUP APPROVED

DEC 16 1996

NOV 21 1996

DATE 7/12/96

COMMISSION

LAND CORNER RECORDATION CERTIFICATE Filing Requirement of Act 74, Mich. P.A. 1970

For corners in

Table with columns: Schoolcraft (County), Located in:, Corner Code #. Rows include Public Land Survey, Property Controlling in Section, and Miscellaneous Property in Sec.

Received & Filed this 8th day of October 1996 at 11:26 AM

Sigrid I. Hedberg Schoolcraft Co. Reg. of Deeds

Register of Deeds Stamp & File Number

4. Lot No. , Recorded Plat
5. Private Claims

Thomas P. O'Brien in a field survey on Aug. 15, 1996 do hereby state that under requirements of P.A. 74, Michigan P.A. of 1970, the corner points mentioned in lines 1 and 2 above were in conformance with regulations and rules therefore as required in the current manual of survey instructions of the United States Department of the Interior, Bureau of Land Management or by a decree of a Court of Law and/or that the corner points mentioned in lines 3, 4 and 5 above were in conformance with the rules of the Michigan Board of Land Surveyors or by a Decree of a Court of Law; established, re-established, monumented, recovered, found as expressed below:

NOTE: Not more than 2 corners, all in the same town and range, may be recorded on this certificate.

Grid table with columns A-M and rows 1-13. Contains numbers 1-36 and an 'X' at row 11, column H.

A. Description of original monument and accessories and/or subsequent restoration:

H-11 (N 1/4 Corner of Section 34) Sept 13, 1850 Algernon Merryweather D.S. set qr. section post. Birch 8 in. S53W 27 links Birch 4" N42E 41"

B. Description of corner evidence found and/or method applied in restoring or reestablishing corner:


H-11 June 30, 1983 Donald R. Schofield RLS set 3/8" steel reinforcing bar by 18" with cap #25871, by single proportionate measurement between G-11 and I-11, as noted in Liber 1 pg. 329.

August 15, 1996 Thomas P. O'Brien P.S. failed to recover corner as set by Donald R Schofield on June 30, 1983. Reset corner by single proportionate measurement between G-11 and I-11. Witnesses recovered check corner position as set by Schofield.

C. Description of monument for corner and accessories established to perpetuate locating the position of the corner:

H-11 Set Schoolcraft County monument stamped to identify.

- Witnesses: (Fd.) 7" Tamarack - S30°W - 76.43'
(Fd.) 9" Tamarack - S45°E - 105.58'
(Fd.) Fence Post Corner - N80°E - 42.75' (M)
5" Aspen - N58°W - 126.25'
4" Cedar post - West - 15.0'

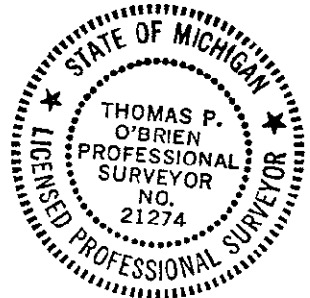

Signed by Thomas P. O'Brien Date August 15, 1996
Surveyor's Michigan License No. 21274