

SCHOOLCRAFT COUNTY PEER GROUP APPROVED

DEC 16 1996

NOV 21 1996

DATE 7/12/96 LAND CORNER RECORDATION CERTIFICATE

Filing Requirement of Act 74, Mich. P.A. 1970

For corners in

Schoolcraft County Located In: Corner Code #/ Public Land Survey T 42N R 15W I-11

Received & Filed this 8th day of October 19 96 at 11:36 AM Sigrid I. Hedberg Schoolcraft Co. Reg. of Deeds

Register of Deeds Stamp & File Number

Grid table with columns A-M and rows 2-13. Cell (11, J) contains an 'X'.

I, Thomas P. O'Brien, in a field survey on August 15, 1996, do hereby certify that under requirements of P.A. 74, Michigan P.A. of 1970, the corner points mentioned in lines 1 and 2 above were in conformance with regulations and rules therefore as required in the current manual of survey instructions of the United States Department of the Interior, Bureau of Land Management or by a decree of a Court of Law and/or that the corner points mentioned in lines 3, 4 and 5 above were in conformance with the rules of the Michigan Board of Land Surveyors or by a Decree of a Court of Law; established, re-established, monumented, re-monumented, recovered, found as expressed below:

NOTE: Not more than 4 corners, all in the same town and range, may be recorded on this certificate.

A. Description of original monument and accessories and/or subsequent restoration:

I-11 (Section Corner common to sections 26,27,34,35) Sept. 18,1850 Algernon Merryweather D.S. set corner post. Birch 20 in. N50E 20 links Hemlock 18" S50W 21"


B. Description of corner evidence found and/or method applied in restoring or reestablishing corner:

I-11 Sept. 3,4, 1900 A.C. Carpenter, County Surveyor "Buried a cobble stone 6" in diameter at corner marked + from original Hemlock stump 18 in. S50W 21". June 30,1983 Donald R. Schofield, RLS set 3/8" steel reinforcing bar with cap by " proportionate measurements," as recorded in Liber 1 pg. 331 Schoolcraft County Register of Deeds. Aug. 15, 1996. Thomas P. O'Brien, PS recovered 3/8" iron rod w/Schofield cap #25871. Reset with Schoolcraft County Monument.

C. Description of monument for corner and accessories established to perpetuate locating the position of the corner:

I-11 Set Schoolcraft County Monument stamped to identify.

Witnesses: Cedar 8" S30°W - 65.47' Fd. Ex. Cond. Cedar 10" S50°E - 82.46' Fd. " " Tamarack 10" N75°E - 67.82' Fd. Ex. Cond. Birch 8" N27°W - 59.10' " " " Set 4" Cedar Post - North - 15.0'

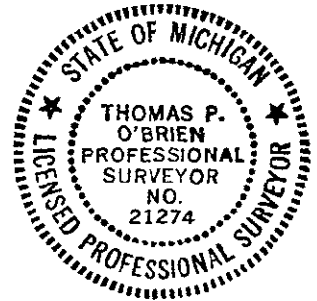

Signature of Thomas P. O'Brien

Signed by Thomas P. O'Brien Date August 15, 1996

Surveyor's Michigan License No. 21274