

**SCHOOLCRAFT COUNTY
PEER GROUP APPROVED**

DATE 7/12/96 **LAND CORNER RECORDATION CERTIFICATE**
Filing Requirement of Act 74, Mich. P.A. 1970

For corners in

Schoolcraft (County)	Located In:	Corner Code #
1. Public Land Survey	T <u>42 N</u> R <u>15 W</u>	<u>I-13</u> ✓
	T <u>41 N</u> R <u>15 W</u>	<u>I-1</u>
	T _____ R _____	_____
	T _____ R _____	_____
2. Property Controlling in Section	S _____ T _____ R _____	_____
	S _____ T _____ R _____	_____
3. Miscellaneous Property in Sec.	S _____ T _____ R _____	_____
	S _____ T _____ R _____	_____
4. Lot No. _____, Recorded Plat _____		
5. Private Claims _____		

Received & Filed this 8th day of
October 1996 at 11:33 A M
Sigrid I. Hedberg
Schoolcraft Co. Reg. of Deeds

Register of Deeds Stamp & File Number

I, Thomas P. O'Brien, in a field survey on August 13, 1996, do hereby certify that under requirements of P.A. 74, Michigan P.A. of 1970, the corner points mentioned in lines 1 and 2 above were in conformance with regulations and rules therefore as required in the current manual of survey instructions of the United States Department of the Interior, Bureau of Land Management or by a decree of a Court of Law and/or that the corner points mentioned in lines 3, 4 and 5 above were in conformance with the rules of the Michigan Board of Land Surveyors or by a Decree of a Court of Law; established, re-established, monumented, re-monumented, recovered, found as expressed below:

NOTE: Not more than 4 corners, all in the same town and range, may be recorded on this certificate.

A. Description of original monument and accessories and/or subsequent restoration:

I-13 (S.E. Corner Sec. 34)
Aug. 6, 1845 John Burt D.S. set corner post.
W. Birch 10 N73W 19 Hemlock 9 N68E 33

Sept. 9/45 John Burt D.S. South between sections 2&3
Hemlock 10 S73W 12 do 7 S65E 16

B. Description of corner evidence found and/or method applied in restoring or reestablishing corner:


I-13 June 30, 1983 Donald R. Schofield R.L.S. 25871 re-established corner by extension of line controlled by G-13 and H-13.

August 13, 1996 Thomas P. O'Brien P.S. re-established corner by single proportionate measurement between H-13 and J-13. No Evidence of Schofield corner recovered.

C. Description of monument for corner and accessories established to perpetuate locating the position of the corner:

I-13 Set Schoolcraft County Monument stamped to identify.

Witnesses: 8" Cedar - S48°W - 49.90'
10" Maple - N32°W - 150.40'
Power Pole - N60°E - 90.38'
2" Cedar - S50°E - 29.10'
4" Cedar Post - N4°E - 30.0'

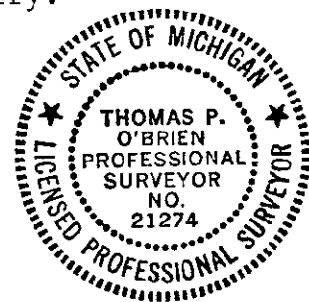

Signed by Thomas P. O'Brien Date August 13, 1996

Surveyor's Michigan License No. 21274

	A	B	C	D	E	F	G	H	I	J	K	L	M
2	6		5		4		3		2		1		
3													
4	7		8		9		10		11		12		
5													
6	18		17		16		15		14		13		
7													
8	19		20		21		22		23		24		
9													
10	30		29		28		27		26		25		
11													
12	31		32		33		34		35		36		
13													

SURVEY &
REMONUMENTATION

DEC 18 1996

COMMISSION