

MAY 16 1997

COMMISSION

SCHOOLCRAFT COUNTY
SCHOOLCRAFT COUNTY
THEIR GROUP APPROVED
DATE 12/10/96 JOD

LAND CORNER RECORDATION CERTIFICATE
Filing Requirement of Act 74, Mich. P.A. 1970

For corners in

Schoolcraft (County)	Located In:	Corner Code #
1. Public Land Survey	T 42NR 15W	K-9
	T R	
	T R	
	T R	
2. Property Controlling in Section	S T R	
	S T R	
3. Miscellaneous Property in Sec.	S T R	
	S T R	

Received & Filed this 30 day of
Dec 1996 at 9:26 AM

Sigrid I. Hedberg
Schoolcraft Co. Reg. of Deeds

Register of Deeds Stamp & File Number

4. Lot No. _____, Recorded Plat _____
5. Private Claims _____

Thomas P. O'Brien in a field survey on Dec. 11, 1996 do hereby state that under requirements of P.A. 74, Michigan P.A. of 1970, the corner points mentioned in lines 1 and 2 above were in conformance with regulations and rules therefore as required in the current manual of survey instructions of the United States Department of the Interior, Bureau of Land Management or by a decree of a Court of Law and/or that the corner points mentioned in lines 3, 4 and 5 above were in conformance with the rules of the Michigan Board of Land Surveyors or by a Decree of a Court of Law, established, re-established, monumented, recovered, found as expressed below.

	A	B	C	D	E	F	G	H	I	J	K	L	M
1													
2	6		5		4		3		2		1		
3													
4	7		8		9		10		11		12		
5													
6	18		17		16		15		14		13		
7													
8	19		20		21		22		23		24		
9											X		
10	30		29		28		27		26		25		
11													
12	31		32		33		34		35		36		
13													

NOTE: Not more than 2 corners, all in the same town and range, may be recorded on this certificate.

A. Description of original monument and accessories and/or subsequent restoration:

K-9 (Section Corner common to sections 23,24 25&26.)
Sept. 12, 1850 - Algernon Merryweather D.S. set section post.
Sugar 18 in. N46W 17 links Beech 6 in. S50W 48 links


B. Description of corner evidence found and/or method applied in restoring or reestablishing corner:

K-9 Dec. 11, 1996 - Thomas P. O'Brien, P.S. re-established corner in the centerline of county road and stone fence line to the East. Corner matches occupation.

C. Description of monument for corner and accessories established to perpetuate locating the position of the corner:

K-9 Set I.B. with cap # 21274 in monument box.

- Witnesses:
- 10" Maple - N69°W - 23.75'
 - Power pole - N11°E - 132.45'
 - 24" Maple - S39°E - 97.45'
 - 12" Maple - S66°W - 24.00'
 - 4" Cedar post - West - 25.00'

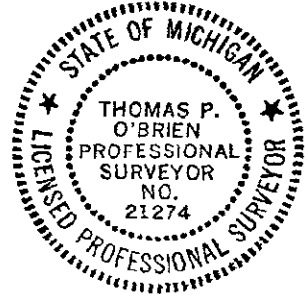

Signed by Thomas P. O'Brien
Surveyor's Michigan License No. 21274

Date Dec. 26, 1996