SCHOOLCRAFT COUNTY
PEER GROUP APPROVED
DATE Dec. 7, 1995

JAN 30 1996
COMMISSION

LAND CORNER RECORDATION CERTIFICATE

Filing Requirement of Act 74, Mich. P.A. 1970

For corners in

Schoolcraft (County)

	Located In:	Corner Code #
1. Public Land Survey	T 42 N R 15 W	M-11
	T 42 N R 14 W	A-11
	T ___ R ___	
	T ___ R ___	
2. Property Controlling	S ___ T ___ R ___	
in Section	S ___ T ___ R ___	
3. Miscellaneous	S ___ T ___ R ___	
Property in Sec.	S ___ T ___ R ___	

Received & Filed this 26 day of Dec. 1995 at 2:32 PM
Sigrid I. Hedberg
Schoolcraft Co. Reg. of Deeds

Register of Deeds Stamp & File Number

4. Lot No. _____, Recorded Plat _____
5. Private Claims _____

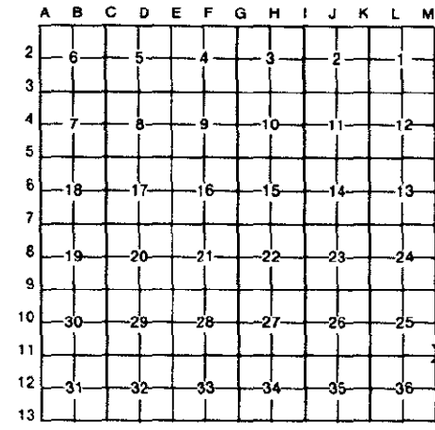

I, Thomas P. O'Brien, in a field survey on Dec.27, 1993, do hereby certify that under requirements of P.A. 74, Michigan P.A. of 1970, the corner points mentioned in lines 1 and 2 above were in conformance with regulations and rules therefore as required in the current manual of survey instructions of the United States Department of the Interior, Bureau of Land Management or by a decree of a Court of Law and/or that the corner points mentioned in lines 3, 4 and 5 above were in conformance with the rules of the Michigan Board of Land Surveyors or by a Decree of a Court of Law; established, re-established, monumented, re-monumented, recovered, found as expressed below:

NOTE: Not more than 4 corners, all in the same town and range, may be recorded on this certificate.

A. Description of original monument and accessories and/or subsequent restoration:

M-11 (S.E. Corner Sec. 25)
Sept. 9, 1850 Algernon Merryweather D.S. set corner post.
Cedar 14 in. N85W 20 links Birch 8 " S28W 43 "

April 17/51 Algernon Merryweather D.S. Corner 30&31.
Cedar 9 in. N37E 26 links Birch 10" S28E 13 "

B. Description of corner evidence found and/or method applied in restoring or reestablishing corner:

M-11 Dec. 29, 1993 Thomas P. O'Brien, PS recovered 1/2" iron bar with plastic PS cap #28406. Testimony of William F. Bowman and measured distances verify corner was set by single proportionment measurement between M7 and M12. Replace 28406 iron bar with Schoolcraft County monument.

C. Description of monument for corner and accessories established to perpetuate locating the position of the corner:

M11 Schoolcraft County monument stamped to identify.
Witnesses:
10" Cedar N73°W 74.50'
Power Pole N10°W 175.65'
Power Pole S30°W 128.91'
Cedar Post East 9.50'
Centerline county road West 14.70'

STATE OF MICHIGAN
THOMAS P. O'BRIEN
PROFESSIONAL SURVEYOR
NO. 21274
LICENSED

Signed by Thomas P. O'Brien Date Dec.20, 1995

Surveyor's Michigan License No. 21274

LIBER 4 PAGE: 20

FORM APPROVED BY MICHIGAN STATE BOARD OF LAND SURVEYORS, JAN. 28, 1971
REVISED MAY 14, 1975
REVISED JAN., 1983