

SCHOOLCRAFT COUNTY  
PEER GROUP APPROVED

SURVEY &  
REMONUMENTATION

JAN 21 1998

DATE 10/15/97

LAND CORNER RECORDATION CERTIFICATE  
Filing Requirement of Act 74, Mich. P.A. 1970

SECTION \_\_\_\_\_

For corners in

<u>Schoolcraft</u> (County)	Located In:	Corner Code #
1. Public Land Survey	T42NR16W T41NR16W	H-13 ✓ H-1
	T___R___	_____
	T___R___	_____
2. Property Controlling in Section	S___T___R___	_____
	S___T___R___	_____
3. Miscellaneous Property in Sec.	S___T___R___	_____
	S___T___R___	_____

Received & Filed this 9 day of  
Dec 1997 at 3:51 PM

Sigrid I. Hedberg  
Schoolcraft Co. Reg. of Deeds

Register of Deeds Stamp & File Number

4. Lot No. \_\_\_\_\_, Recorded Plat \_\_\_\_\_  
5. Private Claims \_\_\_\_\_

Thomas P. O'Brien in a field survey on Oct. 29, 1997 do hereby state that under requirements of P.A. 74, Michigan P.A. of 1970, the corner points mentioned in lines 1 and 2 above were in conformance with regulations and rules therefore as required in the current manual of survey instructions of the United States Department of the Interior, Bureau of Land Management or by a decree of a Court of Law and/or that the corner points mentioned in lines 3, 4 and 5 above were in conformance with the rules of the Michigan Board of Land Surveyors or by a Decree of a Court of Law; established, re-established, monumented, recovered, found as expressed below:

NOTE: Not more than 2 corners, all in the same town and range, may be recorded on this certificate.

	A	B	C	D	E	F	G	H	I	J	K	L	M
1													
2	6		5		4		3		2		1		
3													
4	7		8		9		10		11		12		
5													
6	18		17		16		15		14		13		
7													
8	19		20		21		22		23		24		
9													
10	30		29		28		27		26		25		
11													
12	31		32		33		34		35		36		
13								X					

A. Description of original monument and accessories and/or subsequent restoration:

H-13 S 1/4 Corner Section 34  
Aug. 4, 1845 - John Burt D.S. set qr. section post.  
Spruce Pine 7 N53 E 13 Aspen 4 N27W 60

March 8, 1976 - Thomas P. O'Brien P.S. " found iron bar @ road intersection."


B. Description of corner evidence found and/or method applied in restoring or reestablishing corner:

H-13 Oct. 29, 1997 - Thomas P. O'Brien P.S. recovered a 3/4" iron rod with chisle point 30" long @ road intersection. Witness found verifies corner location as found by Thomas P. O'Brien P.S. March 8, 1976. Reset iron rod with I.B. and O'Brien cap #21274 in monument box.

C. Description of monument for corner and accessories established to perpetuate locating the position of the corner:

H-13 1/2" Iron bar with O'Brien cap #21274 in monument box.

Witnesses: (Fd.) 12"R. Pine - N50°E - 68.30'  
Power Pole - S71°E - 88.94'  
Power Pole - S81°W - 85.65'  
14"R. Pine - N23°W - 65.90'  
C/L 441 - East - 1.0'  
C/L Mstq. Ave. - North - 2.0'

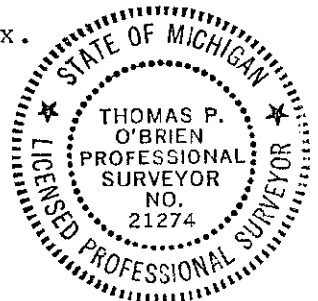

Signed by Thomas P. O'Brien P.S.

Date November 26, 1997

Surveyor's Michigan License No. 21274