

JAN 21 1998

SECTION

SCHOOLCRAFT COUNTY  
PEER GROUP APPROVED

DATE 10/15/97 LAND CORNER RECORDATION CERTIFICATE  
Filing Requirement of Act 74, Mich. P.A. 1970

For corners in

Schoolcraft (County)	Located In:	Corner Code #
1. Public Land Survey	T42NR16W	I-7
	T__R__	_____
	T__R__	_____
	T__R__	_____
2. Property Controlling in Section	S__T__R__	_____
	S__T__R__	_____
3. Miscellaneous Property in Sec.	S__T__R__	_____
	S__T__R__	_____

Received & Filed this 9 day of  
Dec. 1997 at 3:48 PM  
Sigrid I. Hedberg  
Schoolcraft Co. Reg. of Deeds

Register of Deeds Stamp & File Number

4. Lot No. \_\_\_\_\_, Recorded Plat \_\_\_\_\_  
5. Private Claims \_\_\_\_\_

I, Thomas P. O'Brien, in a field survey on Nov. 4, 1997 do hereby state that under requirements of P.A. 74, Michigan P.A. of 1970, the corner points mentioned in lines 1 and 2 above were in conformance with regulations and rules therefore as required in the current manual of survey instructions of the United States Department of the Interior, Bureau of Land Management or by a decree of a Court of Law and/or that the corner points mentioned in lines 3, 4 and 5 above were in conformance with the rules of the Michigan Board of Land Surveyors or by a Decree of a Court of Law; established, re-established, monumented, recovered, found as expressed below:

NOTE: Not more than 2 corners, all in the same town and range, may be recorded on this certificate.

	A	B	C	D	E	F	G	H	I	J	K	L	M
1													
2		6		5		4		3		2		1	
3													
4		7		8		9		10		11		12	
5													
6		13		17		15		15		14		13	
7									X				
8		19		20		21		22		23		24	
9													
10		30		29		28		27		26		25	
11													
12		31		32		33		34		35		36	
13													

A. Description of original monument and accessories and/or subsequent restoration:

- I-7 NE Corner Section 22  
Aug. 14, 1850 - Algernon Merryweather D.S. set corner post.  
Beech 4 N63E 3 lks. Sugar 12 S46W 38 lks.  
April 8, 1976 - Thomas P. O'Brien P.S. recovered a "3/8" I.B. @ road intersection E & W, S." LCRC recorded Liber 1, page 153.  
Feb. 7, 1977 - Beryl M Jones R.L.S. found 1/2" iron. LCRC recorded Liber 1, page 236.


B. Description of corner evidence found and/or method applied in restoring or reestablishing corner:

- I-7 Nov. 4, 1997 - Thomas P. O'Brien P.S. recovered a 3/8" iron rod @ road intersection E & W, S. Witnesses found verify corner location.  
Reset iron rod with I.B. and O'Brien cap #21274 in monument box.

C. Description of monument for corner and accessories established to perpetuate locating the position of the corner:

- I-7 1/2" Iron bar with O'Brien cap #21274 in monument box.

Witnesses: (Fd.) 30" Maple - N10°W - 28.20' (Poor cond.)  
(Fd.) 28" Maple - S46°W - 34.20' (Poor cond.)  
(Fd.) Power Pole - N62°E - 53.60'  
NBT 10" Maple - S37°E - 153.10'  
NBT 30" Maple - S28°W - 64.36'  
NBT 26" Maple - N71°W - 111.68'  
4" Cedar Post - North - 25.0'

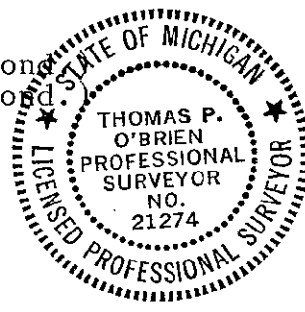

Signed by Thomas P. O'Brien P.S.  
Surveyor's Michigan License No. 21274

Date November 26, 1997