

SCHOOLCRAFT COUNTY  
PEER GROUP APPROVED

DATE 10/15/97

LAND CORNER RECORDATION CERTIFICATE  
Filing Requirement of Act 74, Mich. P.A. 1970

SURVEY & REMONUMENTATION

JAN 21 1998

SECTION

For corners in

Schoolcraft  
(County)

Located In:

Corner Code #

1. Public Land Survey

T42NR16W

I-8

T R

T R

T R

2. Property Controlling in Section

S T

T R

S T

T R

3. Miscellaneous Property in Sec.

S T

T R

S T

T R

4. Lot No. \_\_\_\_\_, Recorded Plat \_\_\_\_\_

5. Private Claims \_\_\_\_\_

Received & Filed this 9 day of  
Dec 1997 at 3:49 PM  
Sigrid I. Hedberg  
Schoolcraft Co. Reg. of Deeds

Register of Deeds Stamp & File Number

	A	B	C	D	E	F	G	H	I	J	K	L	M
1													
2	6		5		4		3		2		1		
3													
4	7		8		9		10		11		12		
5													
6	18		17		16		15		14		13		
7													
8	19		20		21		22	X	23		24		
9													
10	30		29		28		27		26		25		
11													
12	31		32		33		34		35		36		
13													

Thomas P. O'Brien, in a field survey on Nov. 4, 1997 do hereby state that under requirements of P.A. 74, Michigan P.A. of 1970, the corner points mentioned in lines 1 and 2 above were in conformance with regulations and rules therefore as required in the current manual of survey instructions of the United States Department of the Interior, Bureau of Land Management or by a decree of a Court of Law and/or that the corner points mentioned in lines 3, 4 and 5 above were in conformance with the rules of the Michigan Board of Land Surveyors or by a Decree of a Court of Law; established, re-established, monumented, recovered, found as expressed below:

NOTE: Not more than 2 corners, all in the same town and range, may be recorded on this certificate.

A. Description of original monument and accessories and/or subsequent restoration:


I-8 E 1/4 Corner Section 22  
Aug. 14, 1850 - Algernon Merryweather D.S. set qr. section post. Sugar 10 in. N75E 7 lks. Beech 6 in. S55W 8 lks.  
July 11, 1902 - Eugene Ford "post set to 1/4 Old original stump standing bottle burried stump 10 N75E 7 lks." Noted in Co. Surveyors Record pg.26.  
April 8, 1976 - Thomas P. O'Brien P.S. "Fd. 3/8" iron @ Rd. Inter.N&S,W." LCRC recorded Liber 1, page 153.  
Feb. 7, 1977 - Beryl M. Jones R.L.S. found 1/2" iron. LCRC rcorded Liber 1, page 236.

B. Description of corner evidence found and/or method applied in restoring or reestablishing corner:

I-8 Nov. 4, 1997 Thomas P. O'Brien P.S. recovered a 3/8" iron bar tipped 1' below black top surface @ road intersection N&S,W. Witnesses found verify corner location as found by O'Brien on April 8, 1976. Reset I.B. found with 1/2" I.B. and O'Brien cap #21274 in monument box.

C. Description of monument for corner and accessories established to perpetuate locating the position of the corner:

I-8 1/2" Iron bar with O'Brien cap # 21274 in monument box.  
Witnesses: (Fd.) 12" Cedar - S65°E - 31.30'  
(Fd.) Power Pole - S50°W - 43.30'  
N.W. Corner of house - S68°E - 90.30'  
NBT 6" W. Pine - N24°W - 94.22'

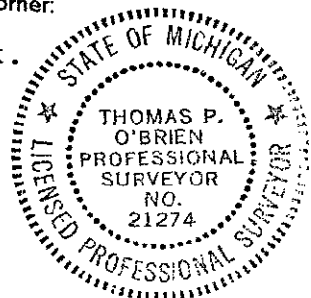

Signed by Thomas P. O'Brien  
Thomas P. O'Brien P.S.

Surveyor's Michigan License No. 21274

Date November 28, 1997

LIBER 4 PAGE: 130